

# HOLIDAY INN OTTAWA

ADDRESS: 140 Lusk St, Ottawa, ON

ISSUED FOR 1st Review Comments Reply - September 15, 2023

ARCHITECTURAL	
ASP-1	SITE PLAN
ASP-2	SITE PLAN-DETAILS
A201	BASEMENT FLOOR PLAN
A202	GROUND FLOOR PLAN
A203	TYPICAL FLOOR PLAN (2ND-3RD)
A204	TOP FLOOR PLAN (4TH)
A205	ROOF PLAN & MECH. PENTHOUSE
A300	3D RENDER
A301	PROPOSED SOUTH ELEVATIONS
A302	PROPOSED EAST & WEST ELEVATIONS
A303	PROPOSED NORTH ELEVATIONS



**CLIENT:**

TROMS HOLDINGS CORP  
601 PAMPLONA PRIVATE  
OTTAWA, ON K2J 5T3

Dr. Sandra Iroakazi  
email: sanirok@yahoo.com

**ARCHITECTURAL**

MATAJ ARCHITECTS INC.  
418 Iroquois Shore Road, Unit 206.  
Oakville, ON L6H 0X7

Artan Mataj  
email: artan@matajarchitects.com  
phone: 905.281.4441 ext 102



**ELECTRICAL**

EJS Engineering  
810 NIPISSING ROAD SUITE 212-214  
MILTON, ONTARIO, L9T 4Z9

Elias J. Shomali  
email: elias@ejsengineering.ca  
phone: 905.216.0898



**LANDSCAPE:**

JAMES B. LENNOX & ASSOCIATES INC.  
3332 Carling Ave.  
Ottawa, ON K2H 5A8

Mike Lennox  
email: ml@jbla.ca  
phone: 613.722.5168



**CIVIL ENGINEER:**

MTE Consultants Inc.  
520 Bingemans Centre Drive,  
Kitchener, Ontario N2B 3X9

Jeff Lerch,  
email: JLerch@mte85.com  
phone: 519-743-6500 x1307



# COVER SHEET



SITE STATISTICS		
ZONING	IP - BUSINESS PARK INDUSTRIAL	
	IP (2265)H(12)	
LOT CALCULATIONS		
LOT AREA	SQM	SFT
LOT COVERAGE	5213.8	56120.9
	24.7%	
SETBACKS		
	MIN REQ'D (m)	PROVIDED (m)
FRONT YARD	6.0	35.16
REAR YARD	6.0	6.00
INTERIOR SIDE	3.0	3.00
INTERIOR SIDE	3.0	3.00
WIDTH OF LANDSCAPE STRIP		
ABUTTING A STREET	3.0	3.0
MAXIMUM FLOOR SPACE INDEX	2	1
HEIGHT OF BUILDING		
	MAX	PROVIDED
BUILDING HEIGHT (MEASURED FROM GRADE TO T/O ROOF DECK)	12m	12m
CONSTRUCTION AREA		
	SM	SF
BASEMENT FLOOR	1,050	11,307
GROUND FLOOR	1,263	13,590
2ND FLOOR	1,286	13,844
3RD FLOOR	1,286	13,844
4TH FLOOR	1,286	13,844
TOTAL CONSTRUCTION AREA	6,171	66,428
PARKING REQUIREMENTS (BASED ON TABLE 101; AREA "C" ON SCHEDULE 1A)		
- SPACES @ 2.6W x 5.2L	REQ'D	PROVIDED
- 50% of stalls are compact stalls (size at 2.4W x 4.6L per zoning standards)	95	95
HOTEL: 1 SPACE PER GUEST UNIT (95 ROOMS)	95	95
PLACE OF ASSEMBLY (110 PER 100sm OF GFA OF ASSEMBLY AREA)	13	13
BANQUET HALL (130 SQ M)		
REDUCED PARKING SPACES (COMPACT CARS) UP TO 50% OF THE PARKING SPACES		51
TYPICAL PARKING STALLS PROVIDED		52
ACC TYPICAL PARKING STALLS PROVIDED		5
TOTAL NO. OF SPACES	108	108
ACCESSIBLE PARKING (CITY OF OTTAWA ACCESSIBILITY DESIGN STANDARDS)		
	REQ'D	PROVIDED
101-133 PARKING SPACES, THEN 5 ACCESSIBLE SPACES REQ'D	5	5
TYPE A (VAN), MIN WIDTH=3400	2	2
TYPE B, MIN WIDTH=2400	3	3
BICYCLE PARKING (BASED ON TABLE 111A (g)&(i))		
	REQ'D	PROVIDED
HOTEL = 1 PER 1000sm OF GFA	5	5
ALL OTHER (ie. PLACE OF ASSEMBLY) = 1 PER 1500sm OF GFA	1	1
TOTAL NO. OF SPACES	6	6
DRIVEWAYS AND AISLE REQUIREMENTS (SECTION 107)		
	REQ'D (MIN)	PROVIDED
TWO-WAY DRIVEWAY	6.7	6.7
TWO-WAY PARKING AISLE	6.7	6.0/ 6.7
LOADING REQUIREMENTS (SECTION 113)		
	REQ'D	PROVIDED
(SIZE: 3.5W X 9.0L PARALLEL; 3.5W X 7.0 OTHER; 4.2M VERT CLR)	2	0
LOADING SPACE		



2 SITE LOCATION  
ASP-1 N.T.S

1 SITE STATS  
ASP-1 N.T.S



HOLIDAY INN OTTAWA- ROOM MIX						
	1st FLOOR	2nd FLOOR	3rd FLOOR	4th FLOOR	TOTAL	PERCENTAGE
KING	3	6	6	6	21	22%
ACC KING	1	2	2	2	7	7%
QQ	5	15	15	15	50	53%
ACC QQ	1	0	0	0	1	1%
ACC JUNIOR SUITE	0	1	1	0	2	2%
JUNIOR SUITE	1	4	4	5	14	17%
<b>TOTAL</b>	<b>11</b>	<b>28</b>	<b>28</b>	<b>28</b>	<b>95</b>	<b>100%</b>
<b>TOTAL ACC. ROOMS</b>	<b>2</b>	<b>3</b>	<b>3</b>	<b>2</b>	<b>10</b>	<b>11%</b>

2 ROOM MIX  
ASP-1 N.T.S

SITE PLAN LEGEND	
	PROPERTY LINE
	BUILDING SETBACK LINE
	LANDSCAPE BUFFER
	CLUB DEPRESSION
	ENTRY EXIT ACCESS POINTS
	EXISTING TOWN HYDRANT
	PROPOSED LOCATION OF NEW FIRE HYDRANT W/ STEEL BOLLARDS REFER TO CIVIL DWG
	FIRE DEPARTMENT CONNECTION
	HOSE BIB (REFER TO MECHANICAL DWG)
	PAD MOUNTED HYDRO TRANSFORMER W/ STEEL BOLLARDS
	DOUBLE HEADED LIGHT FIXTURE ON CONCRETE BASE REFER TO ELECTRICAL DWG
	SINGLE HEADED LIGHT FIXTURE ON CONCRETE BASE W/ ELECTRICAL OUTLET REFER TO ELECTRICAL DWG
	RECESSED EXTERIOR LIGHT FIXTURE w/ SOFFIT & PROFILE COCHIERE REFER TO ELECTRICAL DWG
	NEW HEAVY DUTY ASPHALT PAVING (REMAINDER OF SITE TO RECEIVE LIGHT DUTY ASPHALT PAVING)
	DECORATIVE NON-SLIP SURFACE PAVING UNDER PORITE COCHIERE REFER TO LANDSCAPE DWG
	LANDSCAPED AREA
	POURED CONCRETE PAD AT LOADING AREA & WASTE COLLECTION
	STEEL BOLLARD (REFER TO DETAIL XX.1)
	PARKING COUNT
	FIRE ROUTE SIGN TO BE POSTED UNDER DESIGNATED MUNICIPAL BYLAW 2003-499. REFER TO DETAIL ZVA.02
	PROPOSED GRADING (REFER TO CIVIL DWG)
	SNOW STORAGE AREA (OWNER TO TAKE NECESSARY PRECAUTIONS W/ SNOW REMOVAL COMPANY)

CREDIT NOTES:	CREDIT NOTES:	SITE PLAN- GENERAL NOTES
THE SITE PLAN IS BASED UPON AND MUST BE REVISITED UPON RECEIVING THE SURVEY FOR THE PROPERTY. MATAJ ARCHITECTS ACCEPTS NO LIABILITY FOR THE ACCURACY OF THE COMPLETENESS OF THE DATA SUPPLIED AND ANY DATA NOT INCLUDED UNDER SEAL OF CERTIFICATION IF ANY.	TOPO SURVEYORS INFO: ANNE OSULLIVAN, VOLLEBEEK LTD. 14 CONCORDE DRIVE, SUITE 500 MIRAMICHI, QUE. K2P 7K6 PHONE: (438) 737-9800 / FAX: (438) 737-1079 EMAIL: MATAJ@MATAJARCHITECTS.COM	1. ALL EXISTING PAVEMENT, CURBS, SIDEWALKS, DRIVEWAYS AND DRIVEWAY AREAS DETERMINED BY THE CONSTRUCTION SHALL BE DEMOLISHED TO THE SATISFACTION OF THE CITY OF OTTAWA.
		2. A 1.5M WIDE STRIP OF 1.0M FROM TREE TRUNK TO PROPOSED DRIVEWAYS AND SIDEWALKS SHALL BE MAINTAINED AS EXISTING. TREE TRUNKS SHALL BE RELOCATED BY THE CONTRACTOR/OWNER TO A SETBACK OF 1.0M, THE COST OF RELOCATION OF ANY TREE IS THE RESPONSIBILITY OF THE DEVELOPER/OWNER.
		3. THE CONTRACTOR/OWNER IS RESPONSIBLE FOR ALL UTILITY LOCATES AND DAMAGES/DISTURBANCE DURING CONSTRUCTION.
		4. ALL BARRIER-FREE ENTRANCES AND BARRIER-FREE PATHS OF TRAVEL MUST COMPLY WITH O.B.C. 3.8.
		5. THE OWNER/CONTRACTOR SHALL SUPPLY ALL FIRE ROUTE AND BARRIER-FREE SIGNS AS SET OUT IN THE TOWN OF OTTAWA BY-LAW AND DESIGN CRITERIA.
		6. ALL EXTERIOR ILLUMINATION TO BE DIRECTED DOWNWARD AS WELL AS SHAWED AND DESIGNED TO MINIMIZE MIRROR GLARE LIGHT DEGRADATION AT THE PROPERTY LINE.
		7. ALL DOWNPOUTS TO BE CONNECTED TO THE STORM DRAINAGE SYSTEM.
		8. ALL CONDENSING UNITS TO BE SCREENED ON THE GROUND FLOOR.
		9. SEPARATE PERMITS ARE REQUIRED FOR ANY SIGNAGE ON THE PROPERTY.
		10. WHERE POSSIBLE TREES ARE TO BE PROTECTED FROM CONSTRUCTION.

3 SITE PLAN  
ASP-1 1:200

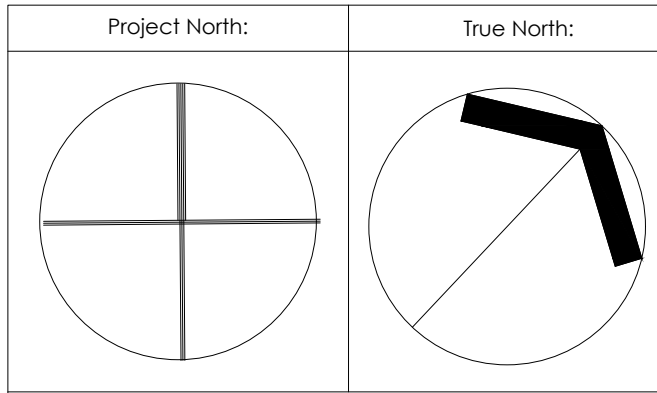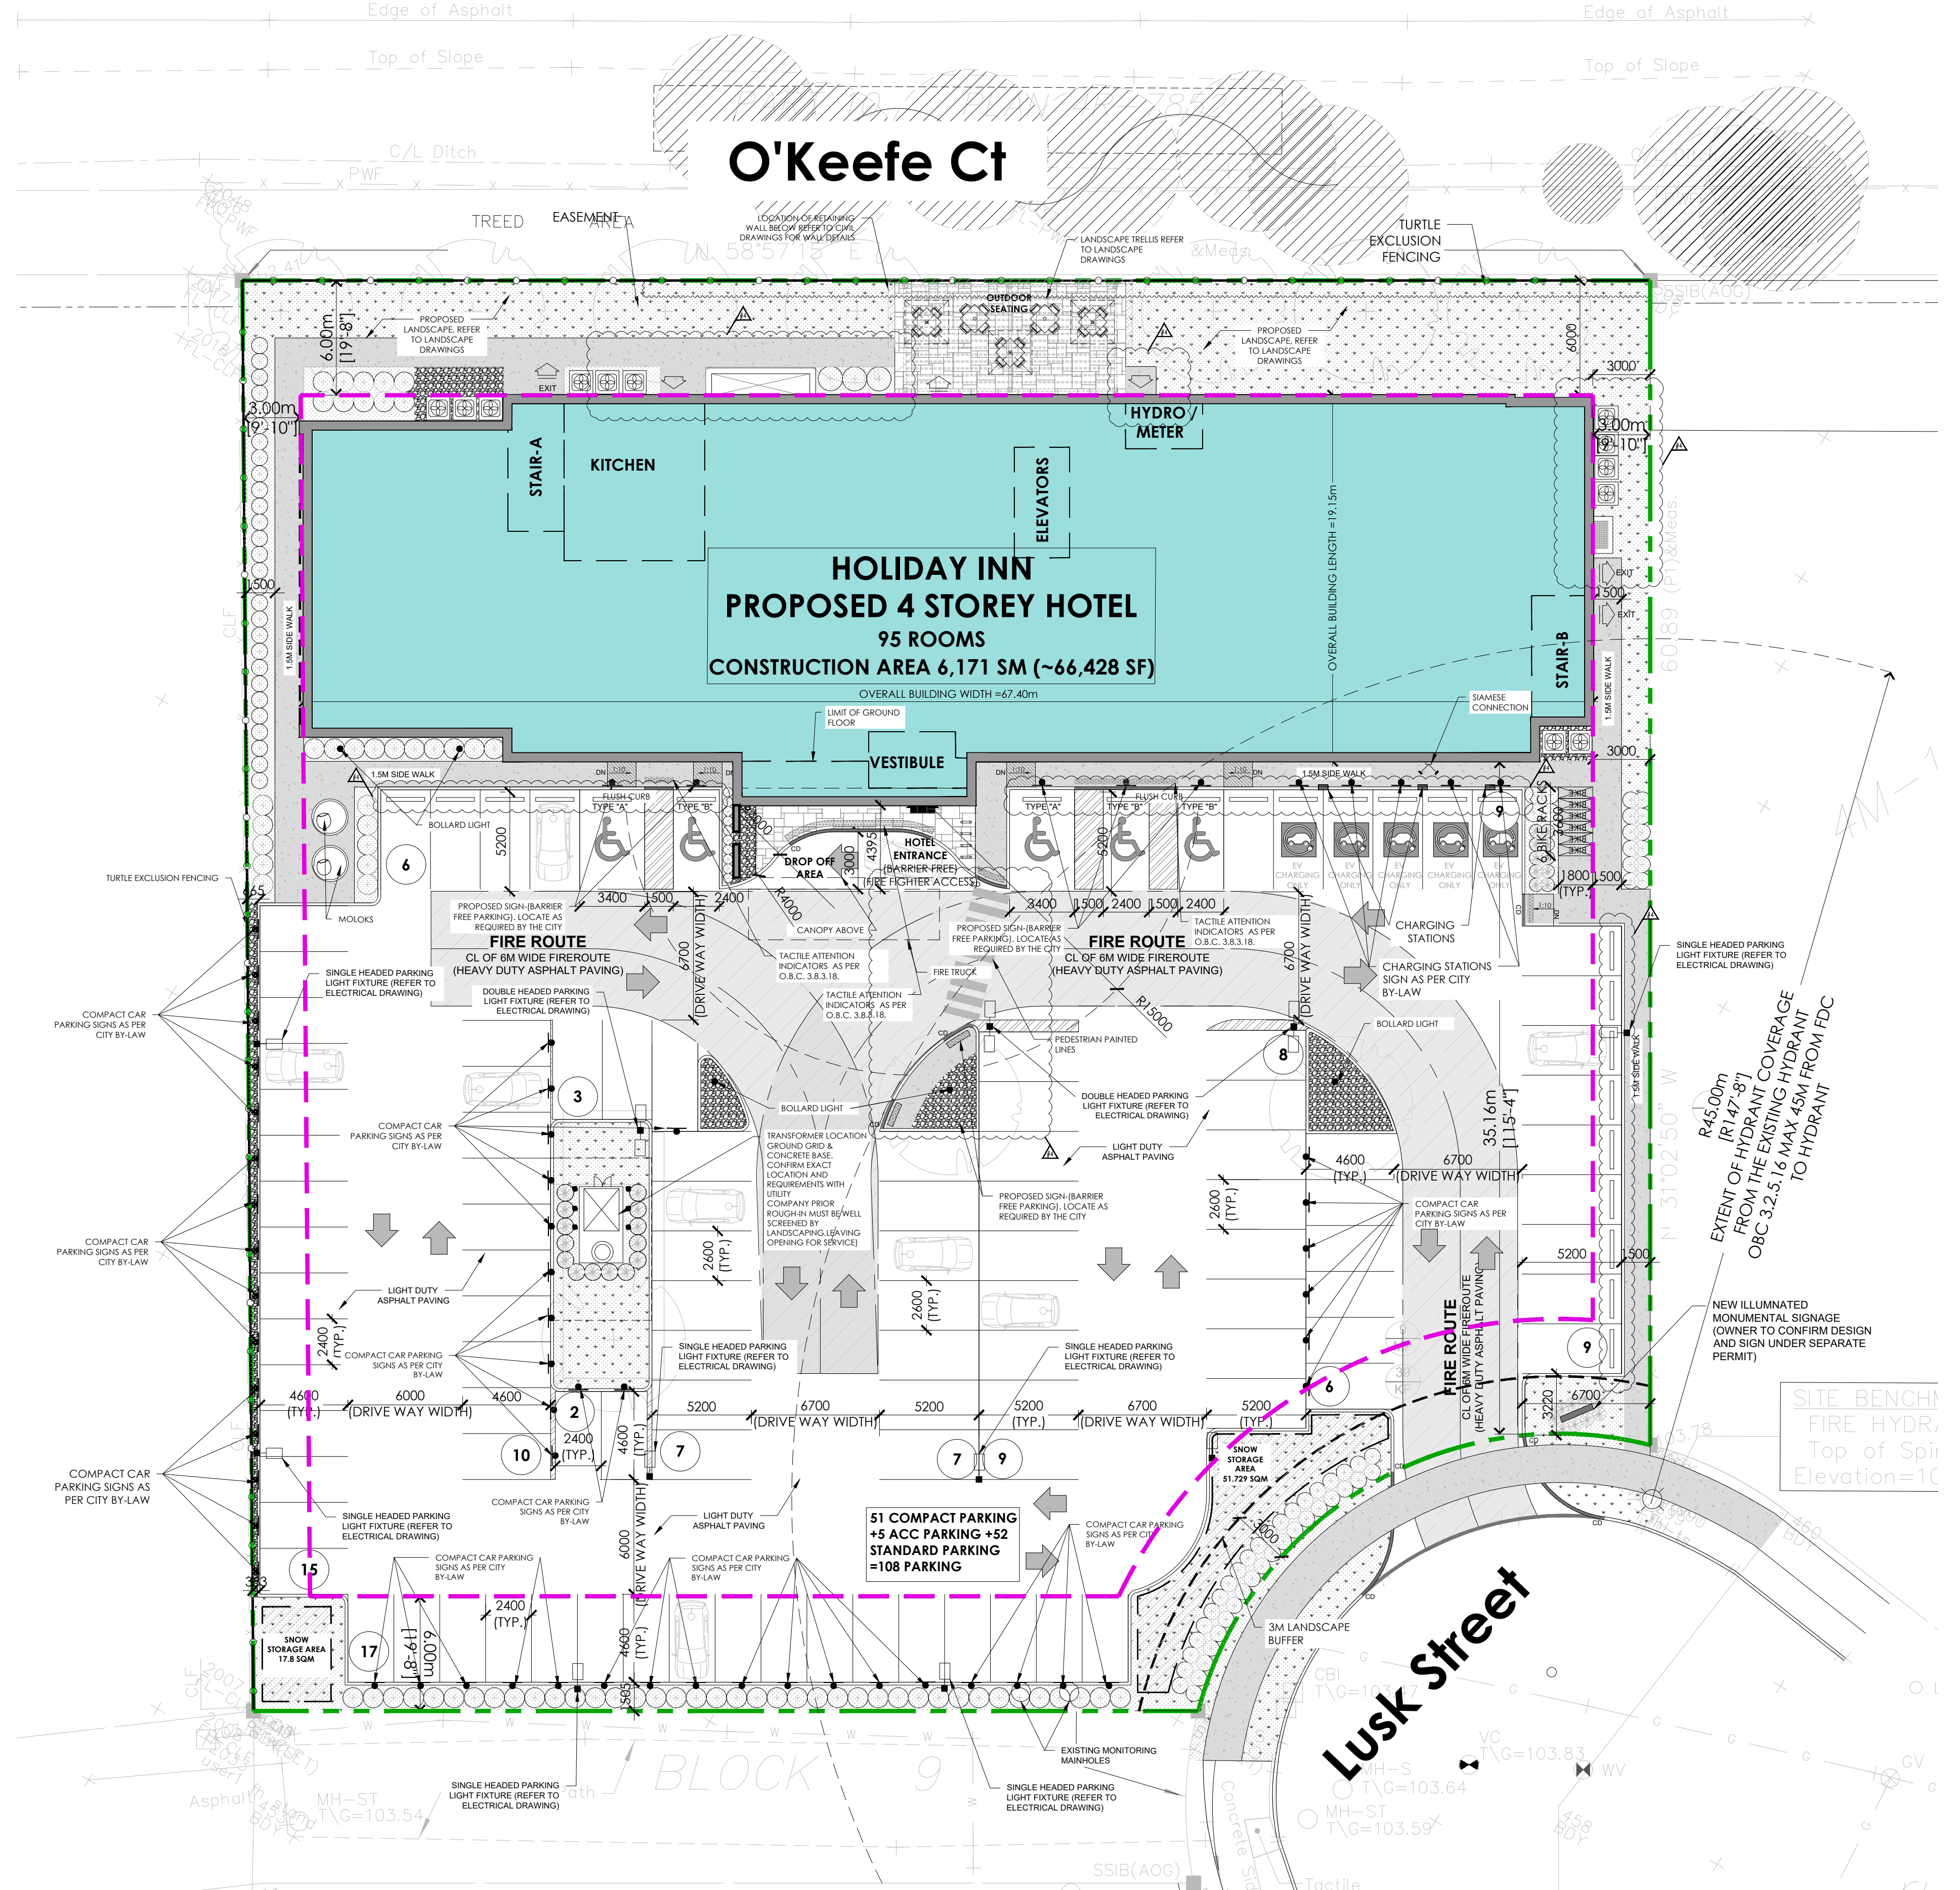

Project North: True North:

Key Plan:

No.	Date:	Issue/Revision	By:
4	2023.09.15	Issued for SPA - 2nd submission	SF
3	2023.04.05	ISSUED FOR 50% BRAND REVIEW	
2	2023.03.03	ISSUED FOR BRAND SUBMISSION	
1	2022.12.09	ISSUED FOR SPA	

Drawing Issues/Revisions:

Note:  
ALL DIMENSIONS AND INFORMATION SHOWN ON THESE DRAWINGS MUST BE CHECKED AND VERIFIED ON SITE AND ANY DISCREPANCIES REPORTED TO THE ARCHITECT PRIOR TO CONSTRUCTION AND FABRICATION OF ITS COMPONENTS. SHOULD EXISTING CONDITIONS OR SERVICES BE FOUND TO VARY FROM THAT INDICATED ON THE DRAWINGS, THE ARCHITECT MUST BE NOTIFIED IMMEDIATELY.


FEATURES OF CONSTRUCTION NOT FULLY SHOWN ARE ASSUMED TO BE THE SAME CHARACTER AS THOSE NOTED FOR SIMILAR CONDITIONS.

UNLESS SPECIFICALLY NOTED OTHERWISE ON THE DRAWINGS, NO PROVISION HAS BEEN MADE IN THE DESIGN FOR CONDITIONS OCCURRING DURING CONSTRUCTION. IT SHALL BE THE RESPONSIBILITY OF THE CONTRACTOR TO PROVIDE ALL NECESSARY BRACING, SHORINGS, SHEET PILING OR OTHER TEMPORARY SUPPORTS, TO SAFEGUARD ALL EXISTING OR ADJACENT STRUCTURES AFFECTED BY THIS WORK.

ALL DRAWINGS AND RELATED DOCUMENTS SHALL REMAIN THE PROPERTY AND COPYRIGHT OF MATAJ ARCHITECTS INC. USE LATEST REVISED DRAWINGS. DO NOT SCALE DRAWINGS.



Architect's Stamp

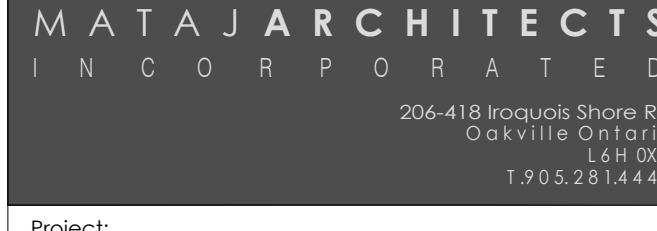

Project:  
**HOLIDAY INN OTTAWA**  
140 Lusk St, Ottawa, ON

Sheet Title:  
**SITE PLAN**

Design By: M.A./H.A. Drawn By: S.F. Approved By: A.M.

Scale: AS SHOWN Date: 22.10.15 Project No.: 22-027

Drawing No.: **ASP-1**

City's Application Number D07-12-22-0180  
City's Plan Number: 19005

















EXTERIOR FINISH SCHEDULE			
	MATERIAL/FINISH	COLOR	NOTES
EIFS			
1	EIFS BY CORNERPOINT OR EQUIVALENT, SMOOTH FINISH	BLACK	
2	EIFS BY CORNERPOINT OR EQUIVALENT, SANDSTONE FINISH	BM, KENDALL CHARCOAL HC-166	
3	ACM PANEL BY SM CLADDING	TIMBER TEAK	
4	EIFS DONE BY CORNERPOINT OR EQUIVALENT SUPPLIED BY STO, StoCreativ Lux	LUMOS SILVER BLUE	
5	ACM PANEL BY SM CLADDING	BONE WHITE	
6	EIFS BY CORNERPOINT OR EQUIVALENT, SMOOTH FINISH	WHITE DOVE, BM OC 151	
7	EIFS PANEL BY DURABOND OR EQUIVALENT, SANDSTONE FINISH	BM, MOZART BLUE 1665	
8	EIFS BY CORNERPOINT OR EQUIVALENT, SMOOTH METALLIC FINISH	BM, FIELD STONE 1558	
9	EIFS 3/4" REVEAL		
10	EXTERIOR GRADE PAINT ON 3" DIAMETER GALVANIZED STEEL COLUMNS, MATTE FINISH	WHITE	
11	STAC-BOND ALUMINUM COMPOSITE PANEL, NATURAL MIRROR FINISH	STB-M01	
12	EIFS BAND 6'X4'	WHITE DOVE, BM OC 151	
LIGHTING			
20	2 LINEAR WHITE STRIPS WITH LENS ON A DIMMER	3000 K	
21	4" X 4" LED LIGHT	3000 K, WHITE LENS	
22	DECORATIVE WALL SCONCE	3000 K	
23	ILLUMINATED SIGNAGE		
24	3x12 SS LED SURFACE MOUNTED DOWNLIGHT	3000 K	
25	PIN LIGHT - VERTICAL DOWN LIGHT	3000 K	
26	ILLUMINATED LIGHT BAR - WHITE DURING THE DAY, ILLUMINATE GREEN DURING THE NIGHT	3000 K	
27	ILLUMINATED LIGHT BAR - WHITE DURING THE DAY, ILLUMINATE WHITE DURING THE NIGHT	3000 K	
OTHERS			
30	H-MONOGRAM		

SPECIAL INSTRUCTIONS	
A	TYPICAL WALL PLANE, 0.00 (5" EIFS)
B	+6" PROJECTING FROM 'A' PLANE
C	-1" RECESSED FROM 'A' PLANE
D	-2" RECESSED FROM 'A' PLANE
E	-3" RECESSED FROM 'A' PLANE
F	-4" RECESSED FROM 'A' PLANE


- GENERAL NOTES:**
- ALL GRILLS IN EXTERIOR ELEVATION PAINTED TO MATCH ADJACENT COLOR.
  - SAMPLES OF ALL EXTERIOR FINISHES AND COLORS SHOULD BE SUBMITTED TO ARCHITECT FOR REVIEW AND APPROVAL BEFORE PROCEEDING WITH CONSTRUCTION
  - CM/BUILDER SHALL PROVIDE ACTUAL SAMPLE FINISHES ON EXTERIOR WALLS FOR OWNERSHIP APPROVAL BEFORE WORK COMMENCES ON FINAL EXTERIOR FINISHES REGARDLESS OF ARCHITECT'S OR OWNERSHIP'S EARLIER SAMPLE APPROVAL IN REGARDS, ESPECIALLY AS IT PERTAINS TO STUCCO COLORS.
  - FOR FIELD APPLIED EIFS, CM/GC TO PROVIDE SHOP DRAWING INDICATING ALL EXTERIOR MECHANICAL PENETRATION AS IT PERTAINS TO THEIR SIZE/LOCATION & FINISH/COLOR
  - SEPARATE SIGN PERMIT REQUIRE FOR EXTERIOR SIGNAGE

**SPANDREL**

HATCH DENOTES BIRD FRIENDLY GLAZING  
 PRODUCT: Guardian Bird1st™ UV  
 BIRD FRIENDLY GLASS BY GUARDIAN GLASS OR APPROVED EQUAL  
<https://www.guardianglass.com/us/en/our-glass/guardian-bird1st-uv>

**SPECIFICATIONS FOR EFFECTIVE VISUAL MARKERS:**

- HIGH COLOUR CONTRAST TO THE GLASS SURFACE.
- MUST BE APPLIED TO THE EXTERIOR (FIRST) SURFACE OF THE GLASS ENSURE THAT PATTERNS REFLECT 20-40% OVER THE 300-400 NANOMETER WAVELENGTH
- INDIVIDUAL MARKER ELEMENTS SHOULD BE A MINIMUM OF 4mm DIAMETER, OR 2mm WIDE BY 8mm LONG FOR LINEAR ELEMENTS.

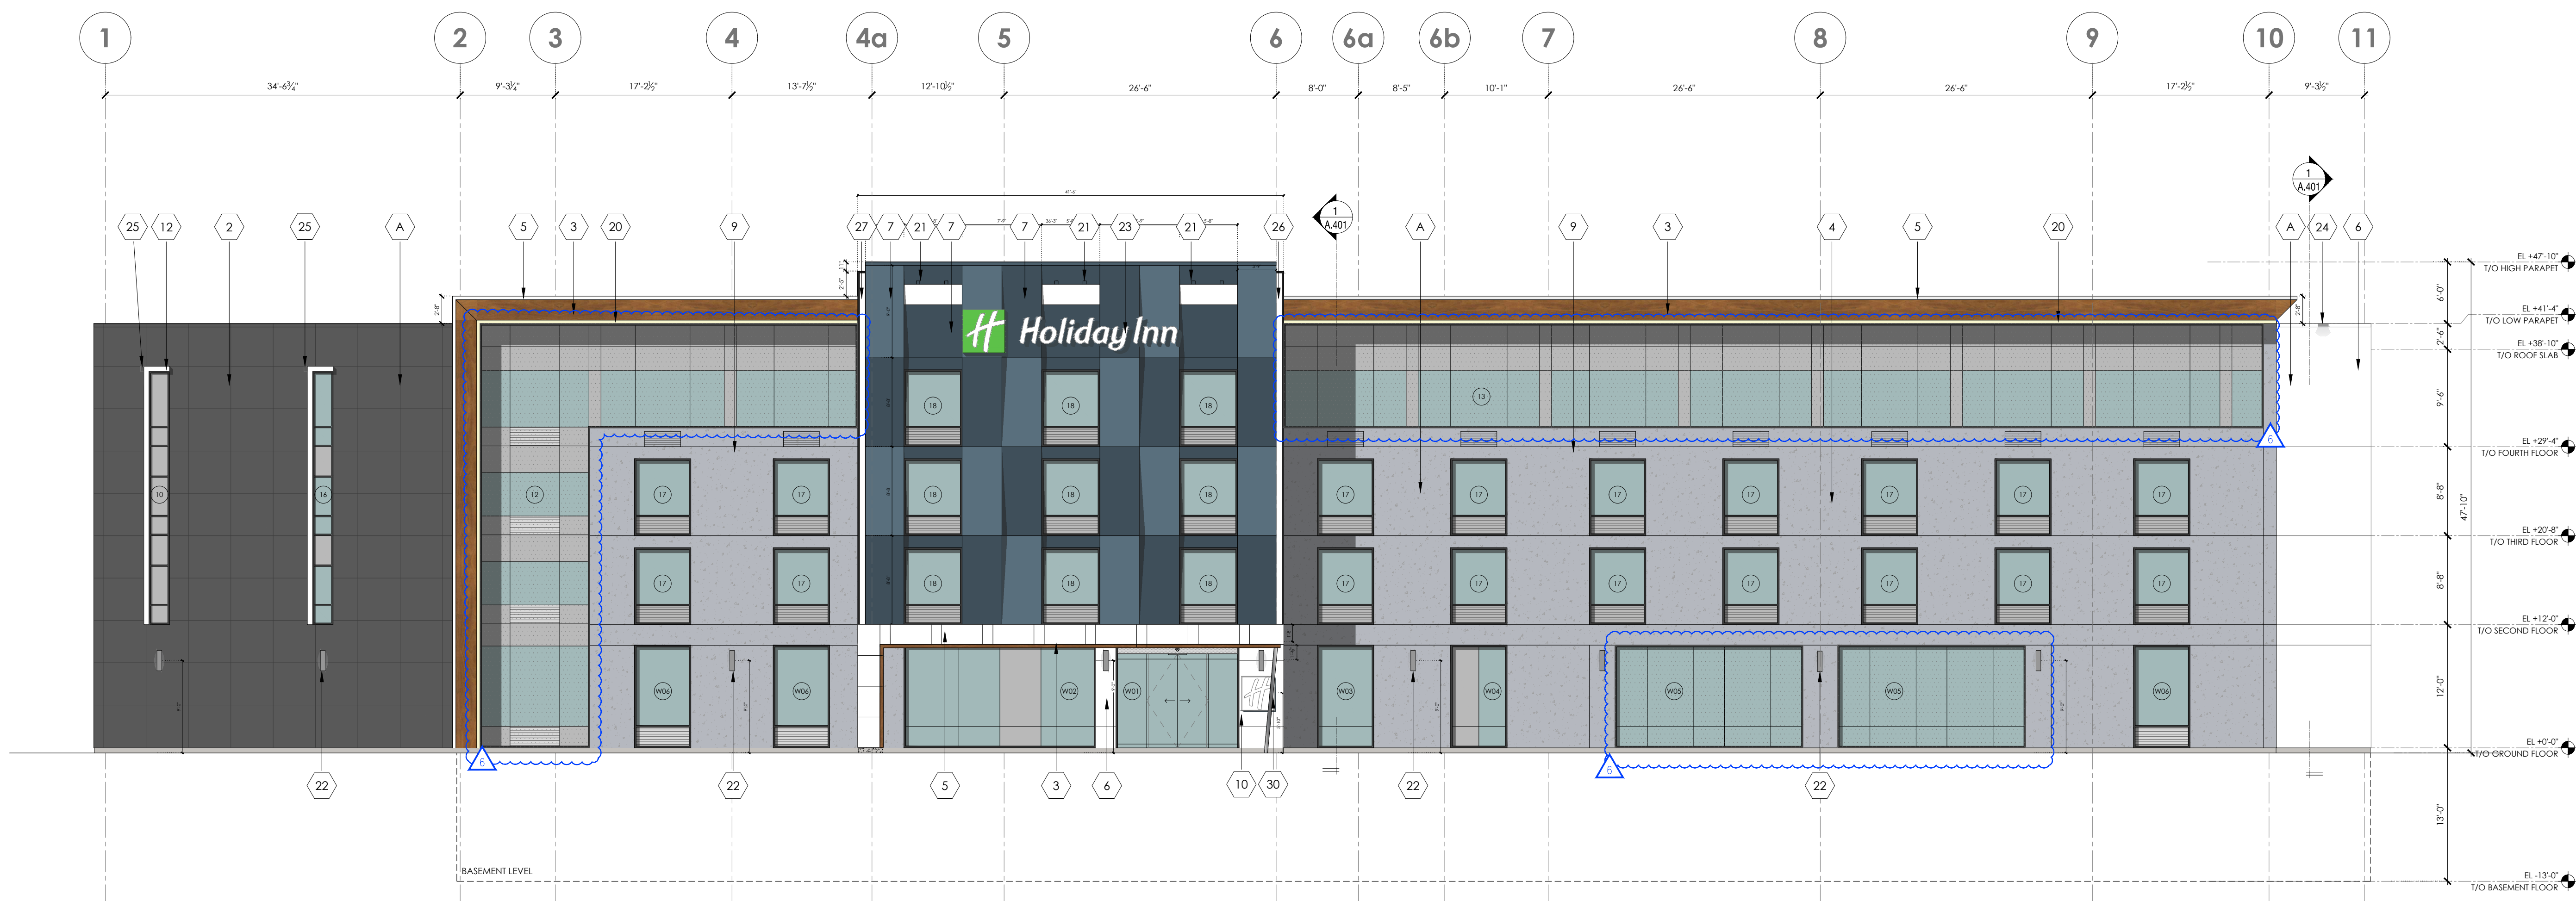

Key Plan:

No.	Date:	Issue/Revision	By:
6	23.09.15	ISSUED FOR SPA - 2ND SUBMISSION	S.F.
5	23.04.05	ISSUED FOR BRAND REVIEW	H.A.
4	23.03.03	ISSUED FOR BRAND SUBMISSION	M.A.
3	23.02.08	ISSUED FOR MINOR VARIANCE SUB.	M.A.
2	22.12.09	ISSUED FOR SPA	M.A.
1	22.10.25	ISSUED FOR MINOR VARIANCE SUB.	M.A.

No.	Date:	Issue/Revision	By:
Drawing Issues/Revisions:			

**Note:**  
 ALL DIMENSIONS AND INFORMATION SHOWN ON THESE DRAWINGS MUST BE CHECKED AND VERIFIED ON SITE AND ANY DISCREPANCIES REPORTED TO THE ARCHITECT PRIOR TO CONSTRUCTION AND FABRICATION OF ITS COMPONENTS. SHOULD EXISTING CONDITIONS OR SERVICES BE FOUND TO VARY FROM THAT INDICATED ON THE DRAWINGS, THE ARCHITECT MUST BE NOTIFIED IMMEDIATELY.

FEATURES OF CONSTRUCTION NOT FULLY SHOWN ARE ASSUMED TO BE THE SAME CHARACTER AS THOSE NOTED FOR SIMILAR CONDITIONS.

UNLESS SPECIFICALLY NOTED OTHERWISE ON THE DRAWINGS, NO PROVISION HAS BEEN MADE IN THE DESIGN FOR CONDITIONS OCCURRING DURING CONSTRUCTION. IT SHALL BE THE RESPONSIBILITY OF THE CONTRACTOR TO PROVIDE ALL NECESSARY BRACING, SHORINGS, SHEET PILING OR OTHER TEMPORARY SUPPORTS, TO SAFEGUARD ALL EXISTING OR ADJACENT STRUCTURES AFFECTED BY THIS WORK.

ALL DRAWINGS AND RELATED DOCUMENTS SHALL REMAIN THE PROPERTY AND COPYRIGHT OF MATAJ ARCHITECTS INC. USE LATEST REVISED DRAWINGS. DO NOT SCALE DRAWINGS.



Architect's Stamp

**MATAJ ARCHITECTS INCORPORATED**  
 204-418 Incoquois Shore Rd  
 Ottawa, Ontario, Canada K1H 0K7  
 1-905-281-4444

Project:  
**HOLIDAY INN OTTAWA**  
 140 Lusk St, Ottawa, ON

Sheet Title:  
**PROPOSED SOUTH ELEVATION**

Design By: M.A./H.A.	Drawn By: S.F.	Approved By: A.M.
Scale: 1/8"=1'-0"	Date: 22.10.15	Project No.: 22-027

Drawing No:  
**A.301**

City's Application Number D07-12-22-0180  
 City's Plan Number: 19005

EXTERIOR FINISH SCHEDULE			
	MATERIAL/FINISH	COLOR	NOTES
<b>EIFS</b>			
1	EIFS BY CORNERPOINT OR EQUIVALENT, SMOOTH FINISH	BLACK	
2	EIFS BY CORNERPOINT OR EQUIVALENT, SANDSTONE FINISH	BM, KENDALL CHARCOAL HC-166	
3	ACM PANEL BY SM CLADDING	TIMBER TEAK	
4	EIFS DONE BY CORNERPOINT OR EQUIVALENT SUPPLIED BY STO, StoCreativ Lux	LUMOS SILVER BLUE	
5	ACM PANEL BY SM CLADDING	BONE WHITE	
6	EIFS BY CORNERPOINT OR EQUIVALENT, SMOOTH FINISH	WHITE DOVE, BM OC 151	
7	EIFS PANEL BY DURABOND OR EQUIVALENT, SANDSTONE FINISH	BM, MOZART BLUE 1665	
8	EIFS BY CORNERPOINT OR EQUIVALENT, SMOOTH METALLIC FINISH	BM, FIELD STONE 1558	
9	EIFS 3/4" REVEAL		
10	EXTERIOR GRADE PAINT ON 3" DIAMETER GALVANIZED STEEL COLUMNS, MATTE FINISH	WHITE	
11	STAC-BOND ALUMINUM COMPOSITE PANEL, NATURAL MIRROR FINISH	STB-M01	
12	EIFS BAND 6"x4"	WHITE DOVE, BM OC 151	
<b>LIGHTING</b>			
20	2 LINEAR WHITE STRIPS WITH LENS ON A DIMMER	3000 K	
21	4" X 4" LED LIGHT	3000 K, WHITE LENS	
22	DECORATIVE WALL SCONCE	3000 K	
23	ILLUMINATED SIGNAGE		
24	3x12 SS LED SURFACE MOUNTED DOWNLIGHT	3000 K	
25	PIN LIGHT - VERTICAL DOWN LIGHT	3000 K	
26	ILLUMINATED LIGHT BAR - WHITE DURING THE DAY, ILLUMINATE GREEN DURING THE NIGHT	3000 K	
27	ILLUMINATED LIGHT BAR - WHITE DURING THE DAY, ILLUMINATE WHITE DURING THE NIGHT	3000 K	
<b>OTHERS</b>			
30	H-MONOGRAM		

SPECIAL INSTRUCTIONS	
A	TYPICAL WALL PLANE, 0.00 (5" EIFS)
B	+6" PROJECTING FROM 'A' PLANE
C	-1" RECESSED FROM 'A' PLANE
D	-2" RECESSED FROM 'A' PLANE
E	-3" RECESSED FROM 'A' PLANE
F	-4" RECESSED FROM 'A' PLANE



- GENERAL NOTES:**
- ALL GRILLS IN EXTERIOR ELEVATION PAINTED TO MATCH ADJACENT COLOR.
  - SAMPLES OF ALL EXTERIOR FINISHES AND COLORS SHOULD BE SUBMITTED TO ARCHITECT FOR REVIEW AND APPROVAL BEFORE PROCEEDING WITH CONSTRUCTION
  - CM/BUILDER SHALL PROVIDE ACTUAL SAMPLE FINISHES ON EXTERIOR WALLS FOR OWNERSHIP APPROVAL BEFORE WORK COMMENCES ON FINAL EXTERIOR FINISHES REGARDLESS OF ARCHITECT'S OR OWNERSHIP'S EARLIER SAMPLE APPROVAL IN REGARDS, ESPECIALLY AS IT PERTAINS TO STUCCO COLORS.
  - FOR FIELD APPLIED EIFS, CM/GC TO PROVIDE SHOP DRAWING INDICATING ALL EXTERIOR MECHANICAL PENETRATION AS IT PERTAINS TO THEIR SIZE/LOCATION & FINISH/COLOR
  - SEPARATE SIGN PERMIT REQUIRE FOR EXTERIOR SIGNAGE

**SPANDREL**

HATCH DENOTES BIRD FRIENDLY GLAZING  
 PRODUCT: Guardian Bird1st™ UV  
 BIRD FRIENDLY GLASS BY GUARDIAN GLASS OR APPROVED EQUAL  
<https://www.guardianglass.com/us/en/our-glass/guardian-bird1st-uv>

**SPECIFICATIONS FOR EFFECTIVE VISUAL MARKERS:**

- HIGH COLOUR CONTRAST TO THE GLASS SURFACE.
- MUST BE APPLIED TO THE EXTERIOR (FIRST) SURFACE OF THE GLASS. ENSURE THAT PATTERNS REFLECT 20-40% OVER THE 300-400 NANOMETER WAVELENGTH
- INDIVIDUAL MARKER ELEMENTS SHOULD BE A MINIMUM OF 4mm DIAMETER, OR 2mm WIDE BY 8mm LONG FOR LINEAR ELEMENTS.

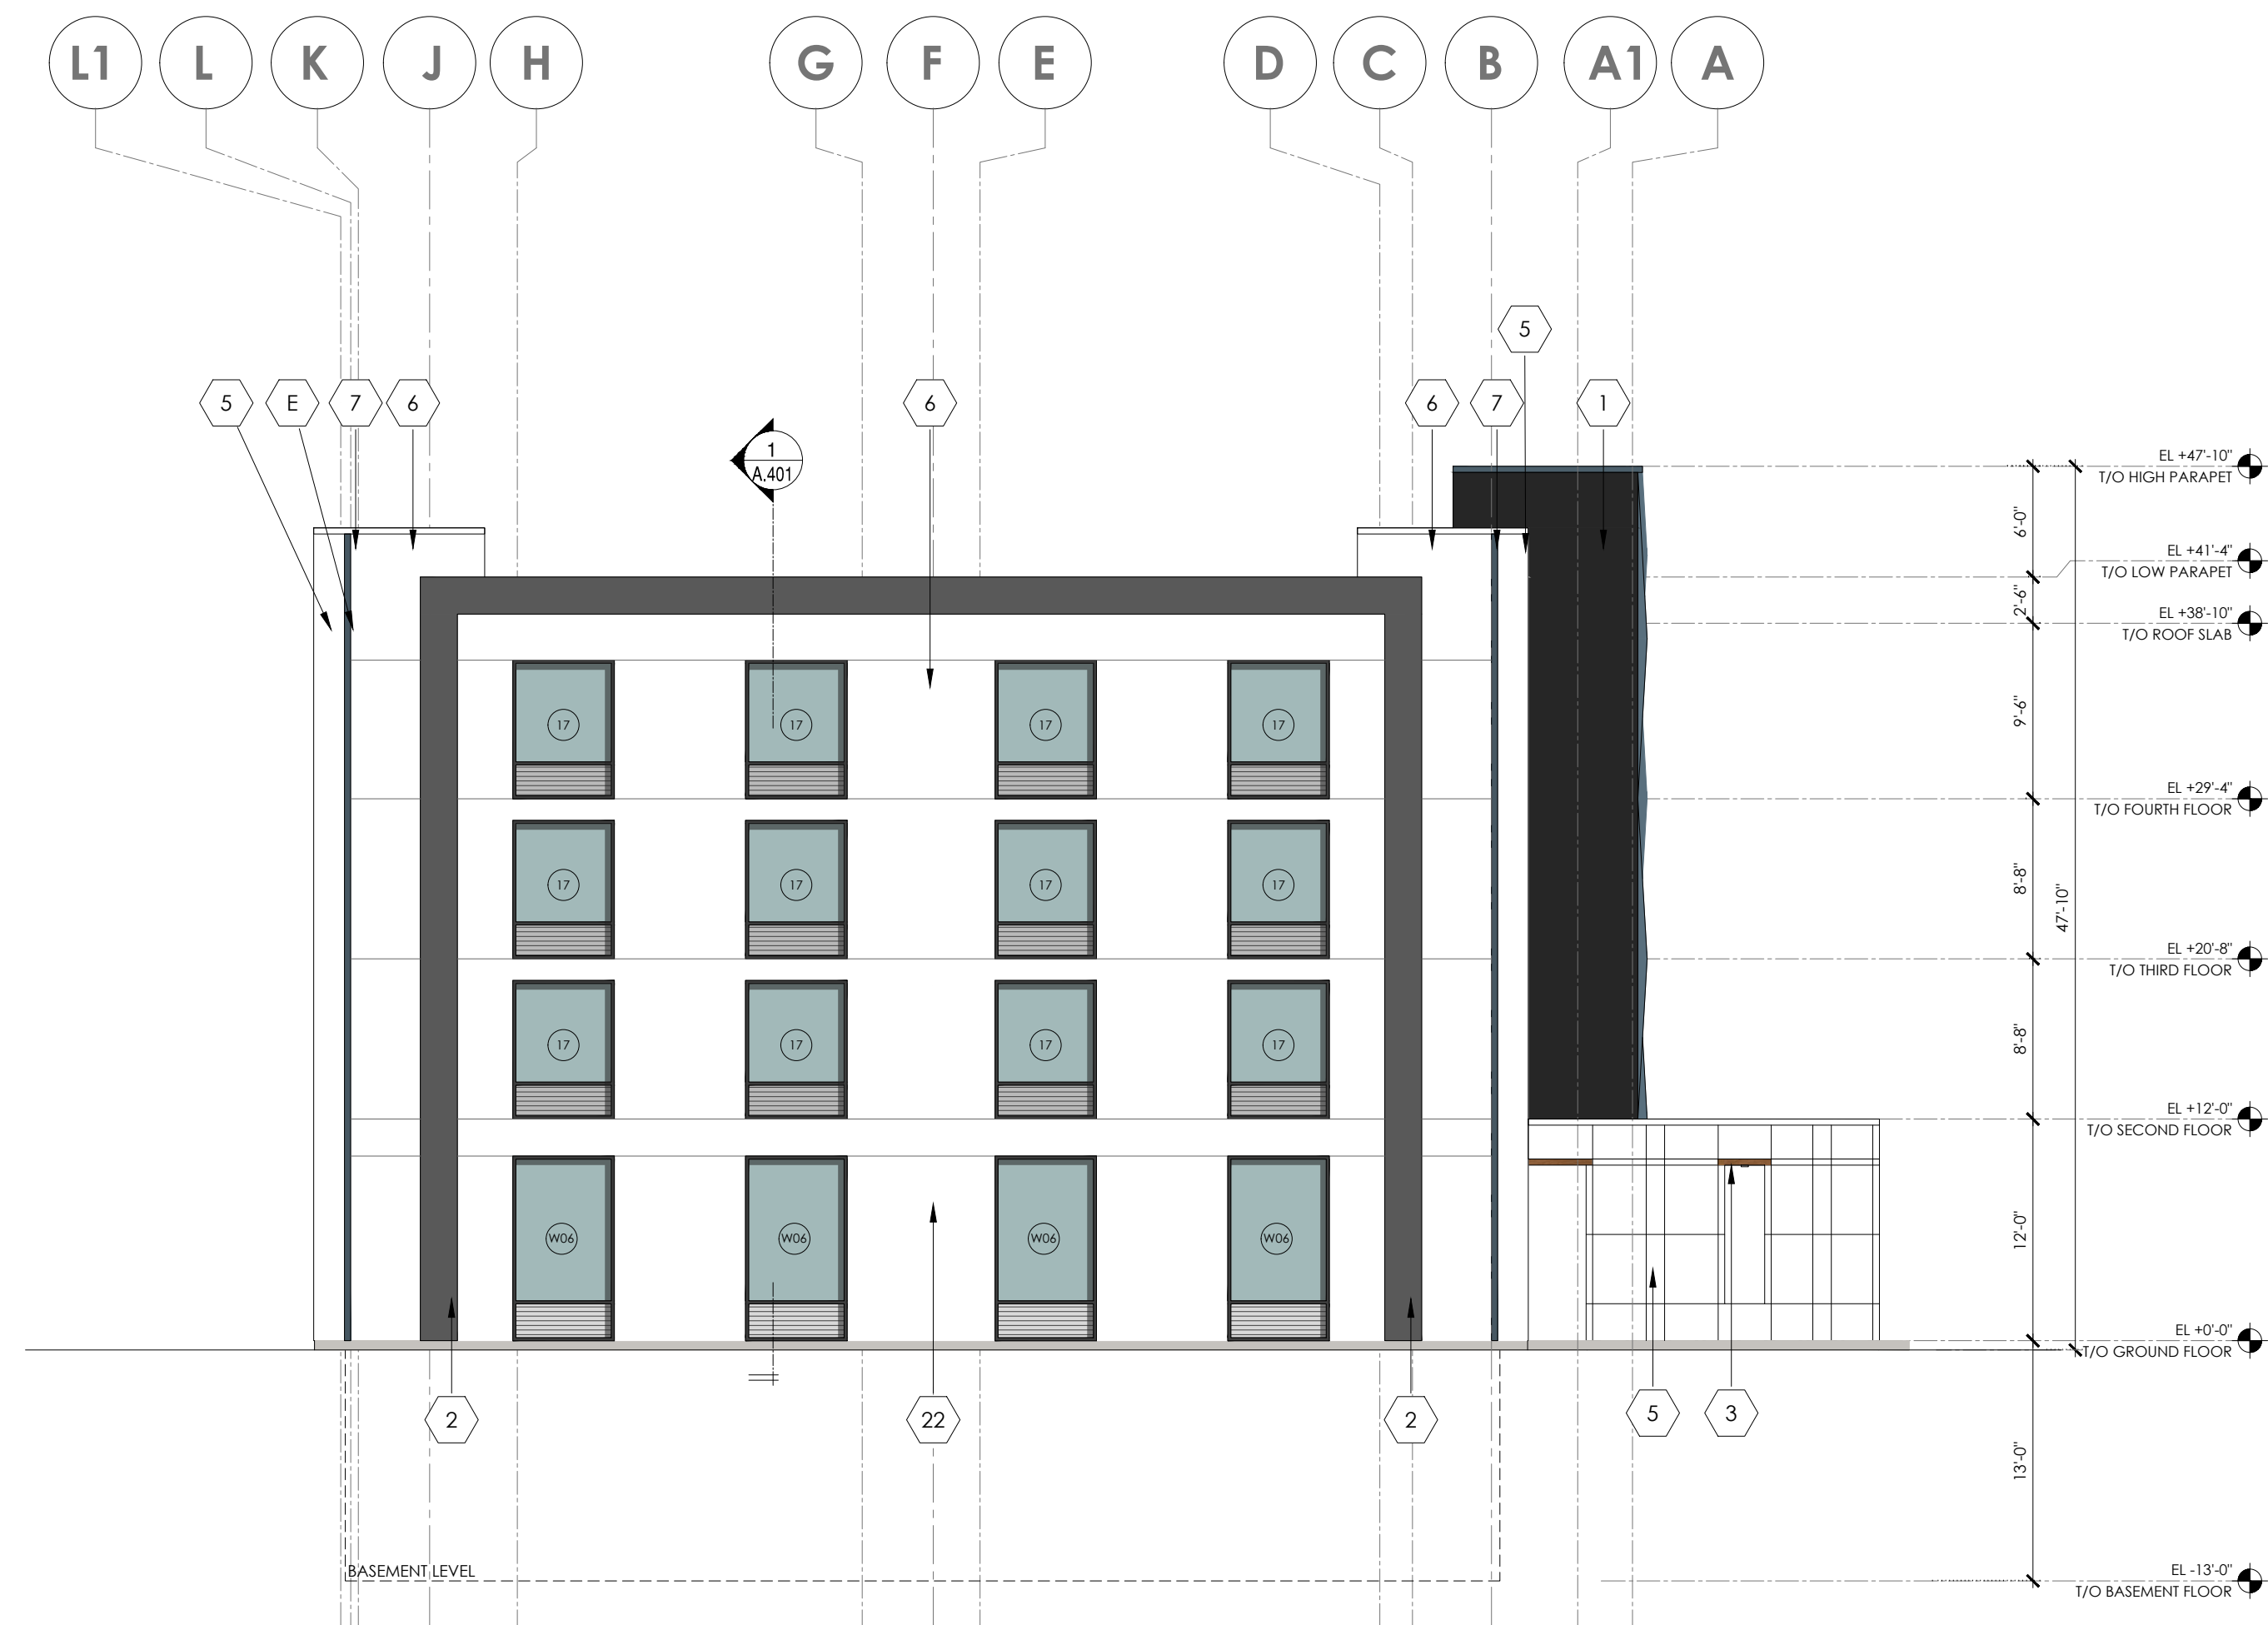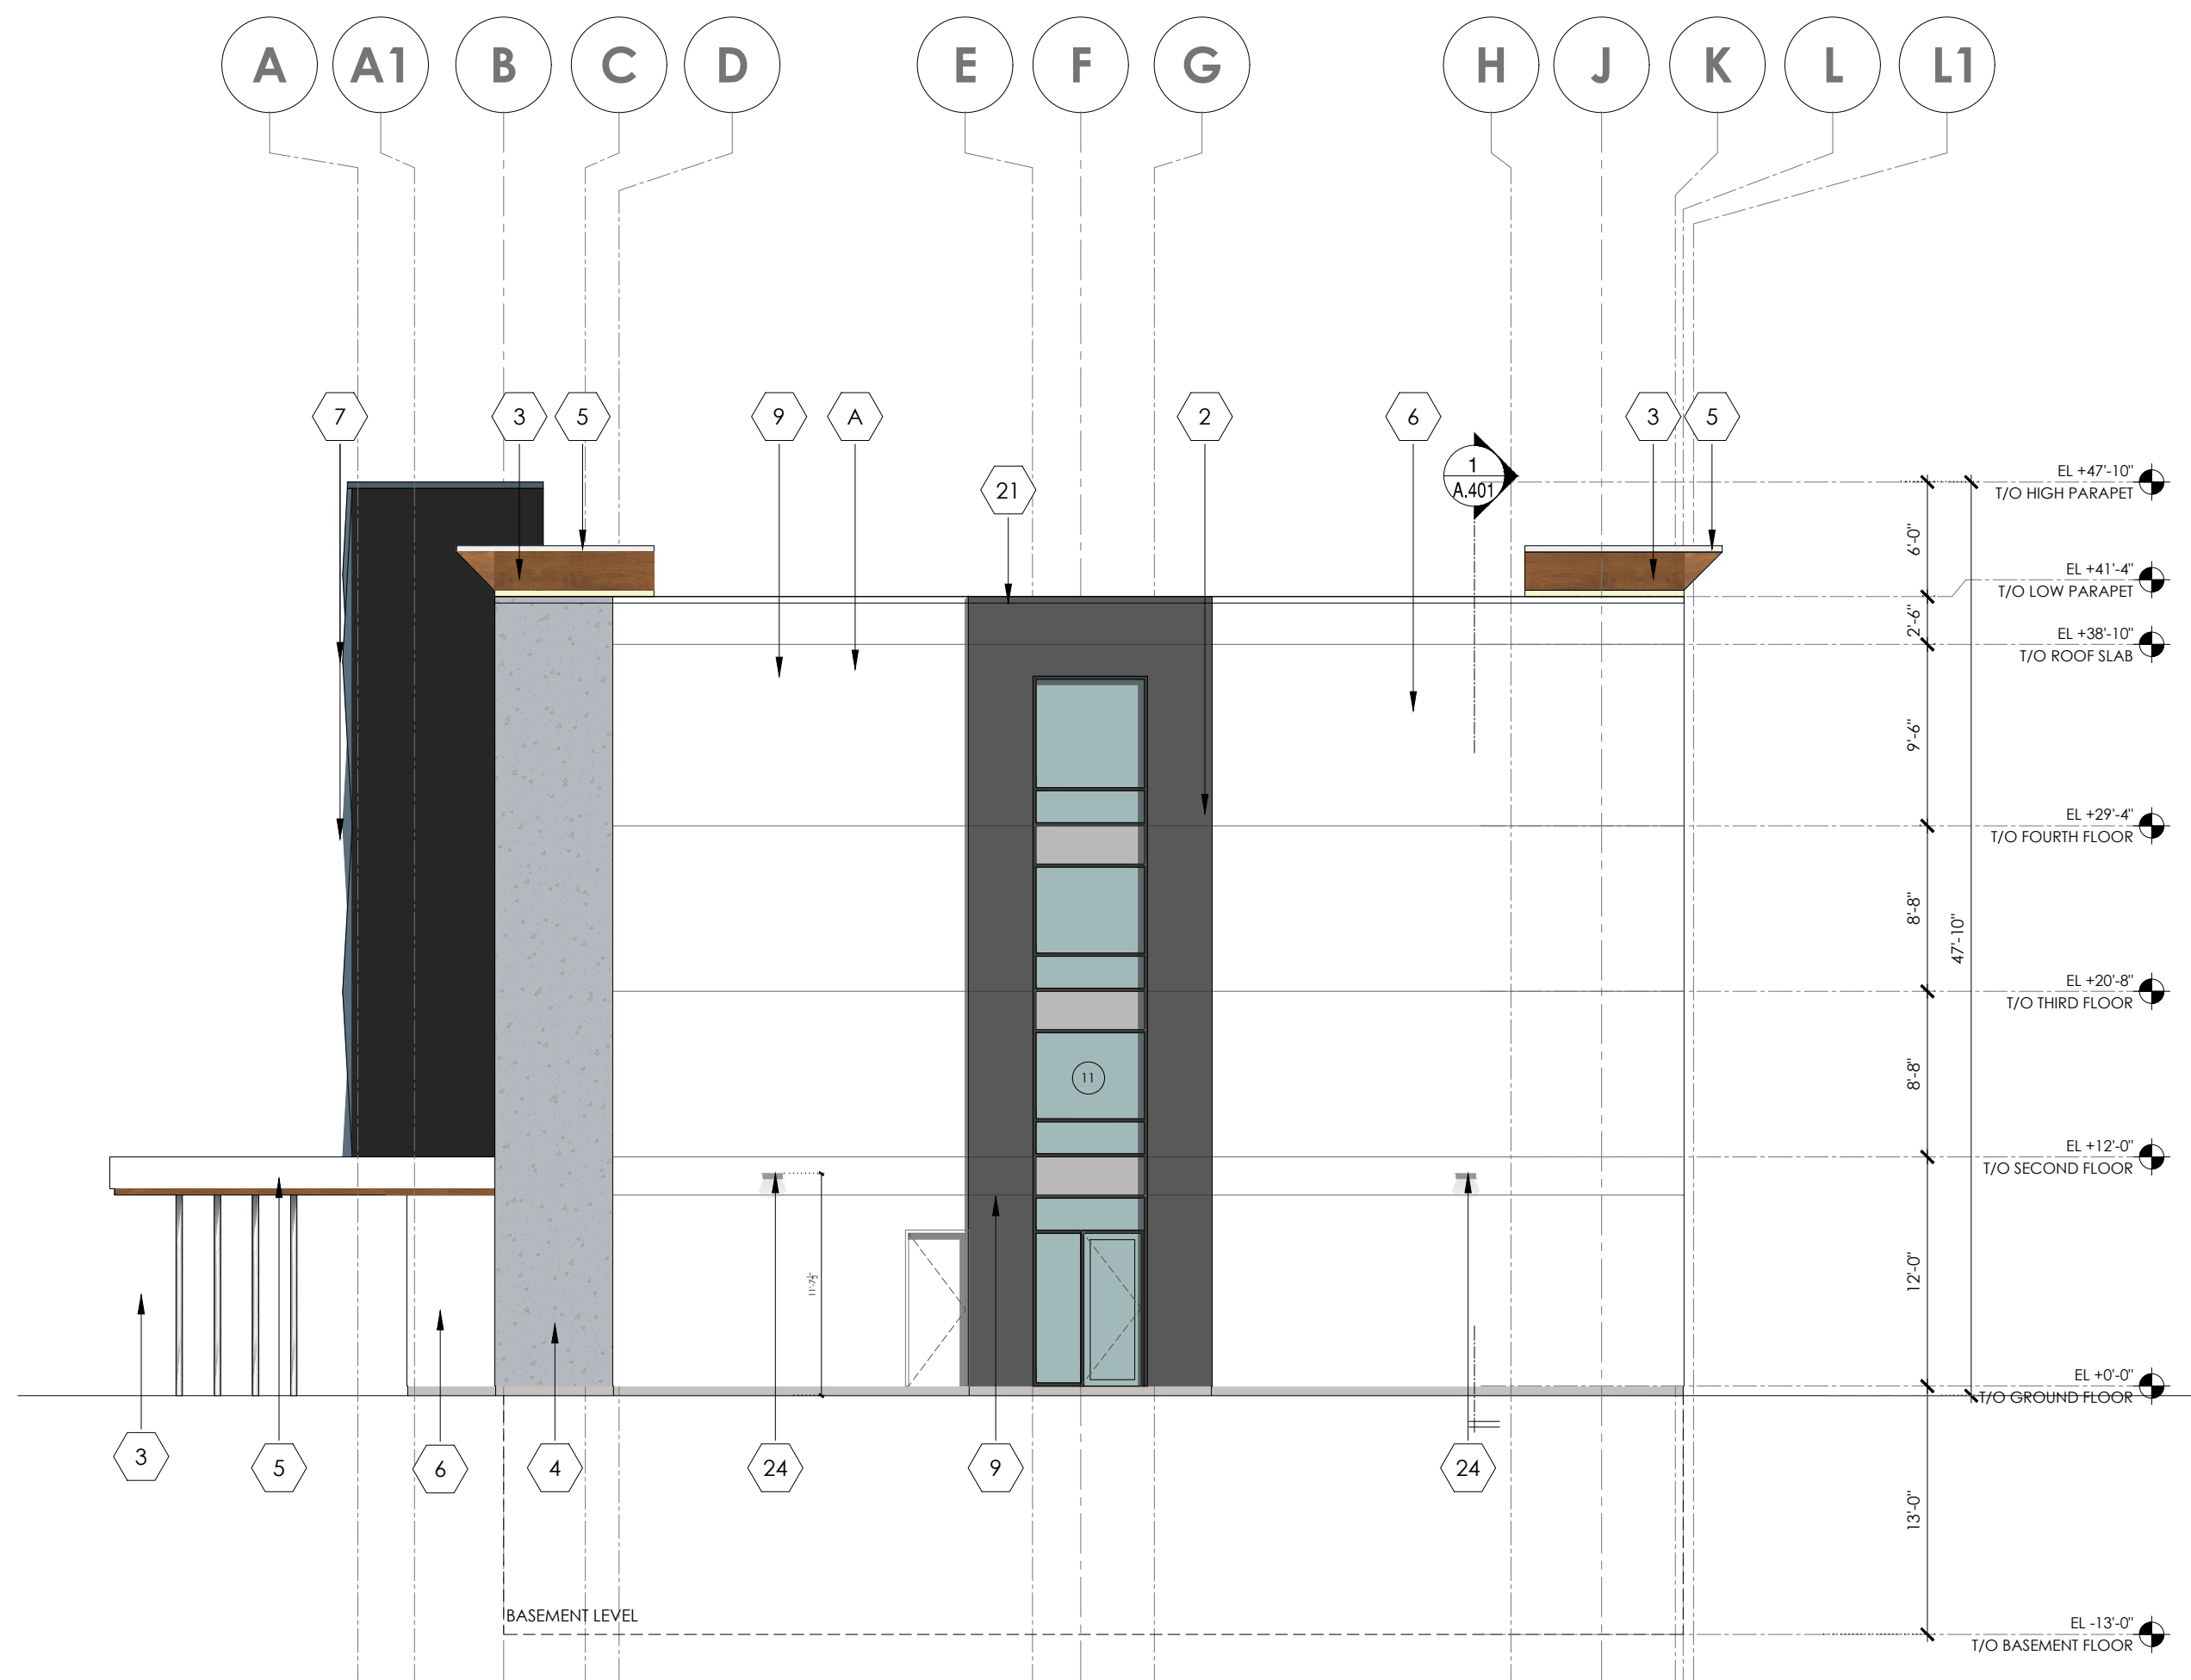

1 PROPOSED EAST ELEVATION  
 A.302 1/8" = 1'-0"

2 PROPOSED WEST ELEVATION  
 A.302 1/8" = 1'-0"

Key Plan:

No.	Date:	Issue/Revision	By:
6	23.09.15	ISSUED FOR SPA - 2ND SUBMISSION	S.F.
5	23.04.05	ISSUED FOR BRAND REVIEW	H.A.
4	23.03.03	ISSUED FOR BRAND SUBMISSION	M.A.
3	23.02.08	ISSUED FOR MINOR VARIANCE SUB.	M.A.
2	22.12.09	ISSUED FOR SPA	M.A.
1	22.10.25	ISSUED FOR MINOR VARIANCE SUB.	M.A.

No.	Date:	Issue/Revision	By:

Drawing Issues/Revisions:

**Note:**  
 ALL DIMENSIONS AND INFORMATION SHOWN ON THESE DRAWINGS MUST BE CHECKED AND VERIFIED ON SITE AND ANY DISCREPANCIES REPORTED TO THE ARCHITECT PRIOR TO CONSTRUCTION AND FABRICATION OF ITS COMPONENTS. SHOULD EXISTING CONDITIONS OR SERVICES BE FOUND TO VARY FROM THAT INDICATED ON THE DRAWINGS, THE ARCHITECT MUST BE NOTIFIED IMMEDIATELY.

FEATURES OF CONSTRUCTION NOT FULLY SHOWN ARE ASSUMED TO BE THE SAME CHARACTER AS THOSE NOTED FOR SIMILAR CONDITIONS.

UNLESS SPECIFICALLY NOTED OTHERWISE ON THE DRAWINGS, NO PROVISION HAS BEEN MADE IN THE DESIGN FOR CONDITIONS OCCURRING DURING CONSTRUCTION. IT SHALL BE THE RESPONSIBILITY OF THE CONTRACTOR TO PROVIDE ALL NECESSARY BRACING, SHORINGS, SHEET PILING OR OTHER TEMPORARY SUPPORTS, TO SAFEGUARD ALL EXISTING OR ADJACENT STRUCTURES AFFECTED BY THIS WORK.

ALL DRAWINGS AND RELATED DOCUMENTS SHALL REMAIN THE PROPERTY AND COPYRIGHT OF MATAJ ARCHITECTS INC. USE LATEST REVISED DRAWINGS. DO NOT SCALE DRAWINGS.



Architect's Stamp

**MATAJ ARCHITECTS INCORPORATED**  
 204-418 Incaquois Shore Rd  
 Ottawa, Ontario K1J 1G1  
 T 905.281.4444

Project:  
**HOLIDAY INN OTTAWA**  
 140 Lusk St, Ottawa, ON

Sheet Title:  
**PROPOSED EAST & WEST ELEVATIONS**

Design By: M.A./H.A.	Drawn By: S.F.	Approved By: A.M.
Scale: 1/8" = 1'-0"	Date: 22.10.15	Project No.: 22-027

Drawing No:  
**A.302**

City's Application Number D07-12-22-0180  
 City's Plan Number: 19005





**PLAN OF SUBDIVISION OF PART OF LOT 20 CONCESSION 4 ( Rideau Front ) Geographic Township of Nepean CITY OF OTTAWA**  
 Surveyed by Annis, O'Sullivan, Vollebek Ltd.

Scale 1:750  
 Metric  
 DISTANCES AND COORDINATES SHOWN ON THIS PLAN ARE IN METRES AND CAN BE CONVERTED TO FEET BY DIVIDING BY 0.3048.

**Surveyor's Certificate**  
 I CERTIFY THAT:  
 1. This survey and plan are correct and in accordance with the Surveys Act, the Surveyors Act and the Land Titles Act and the regulations made under them.  
 2. The survey was completed on the 25th day of February, 2019.

Date: May 7, 2019  
 Signature: Andre Roy  
 Title: Ontario Land Surveyor

**OWNER'S CERTIFICATE**  
 THIS IS TO CERTIFY THAT:  
 1. Blocks 1 to 14, both inclusive, the Streets, namely, rue Forager Street and rue Lusk Street, the Street Widening, namely, Block 19 and the Reserves, namely, Blocks 15, 16, 17 and 18 have been laid out in accordance with our instructions.  
 2. The Streets and Street Widening are dedicated to City of Ottawa as public highways.

Dated the 8 day of May 2019  
 Signature: George Cary  
 Title: Authorized Signing Officer  
 2118885 ONTARIO INC.  
 I have the authority to bind the corporation.


Dated the 10 day of May 2019  
 Signature: Cuckoo Kocher  
 Title: President  
 DCR / PHOENIX DEVELOPMENT CORPORATION LIMITED  
 I have the authority to bind the corporation.

**NOTES AND LEGEND**

- denotes Survey Monument Planted.
- denotes Survey Monument Found.
- SIB Standard Iron Bar.
- SSIB Short Standard Iron Bar.
- CC Cut Cross.
- IB Iron Bar.
- 0.3 long Survey Monument.
- (AOG) Annis, O'Sullivan, Vollebek Ltd.
- (P1) Plan 4R-7852.
- (P2) Plan 4R-20404.
- (P3) Plan 4R-8856.
- (P4) Plan SR-10261.

All planted survey monuments are IB's unless otherwise noted.  
 Distances shown on curved limits are Arc distances unless otherwise noted.

Distances shown on this plan are ground distances and can be converted to grid distances by multiplying by the combined scale factor of 0.999921.  
 Bearings are grid, derived from Can-Nel 2016 Real Time Network GPS observations on reference points A and B, shown hereon, having a bearing of Nxx°xx'xx"W and are referenced to Specified Control Points 01919791338 and 01919871649, MTM Zone 9 (70°30' West Longitude) NAD-83 (original).  
 Coordinates are derived from Can-Nel 2016 Real Time Network GPS observations referenced to Specified Control Points 01919791338 and 01919871649, MTM Zone 9 (70°30' West Longitude) NAD-83 (original).  
 Coordinate values are to urban accuracy in accordance with O. Reg. 216/10.  
 01919791338 Northing 5000555.96 Easting 346140.91  
 01919871649 Northing 5007189.87 Easting 372435.05  
 Point A Northing 5015105.53 Easting 360398.72  
 Point B Northing 5015323.48 Easting 360760.79  
 Caution: Coordinates shown, in themselves, be used to re-establish corners or boundaries shown on this plan.

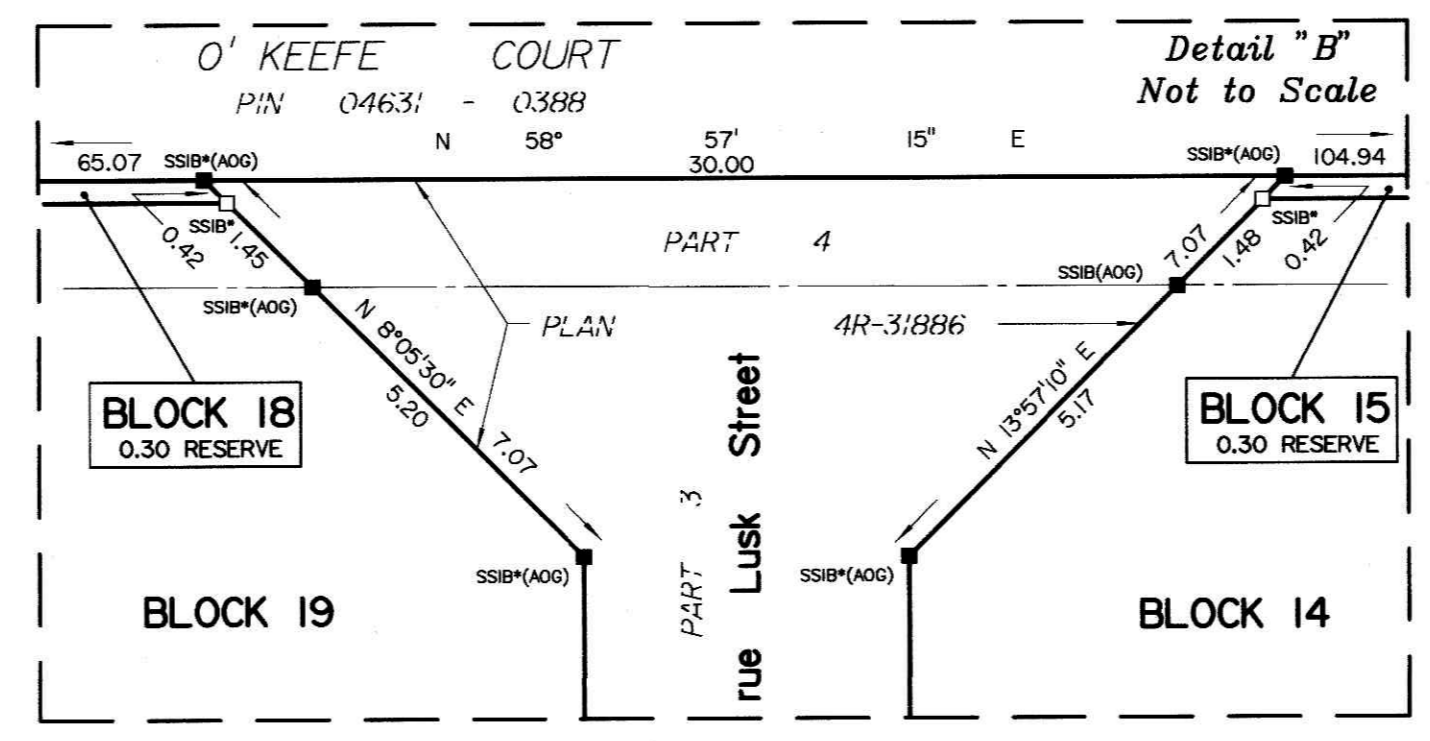

APPROVED UNDER SECTION 51 OF THE PLANNING ACT BY THE CITY OF OTTAWA  
 THIS 26th DAY OF June 2019  
 Signature: Stephen Willis  
 Title: GENERAL MANAGER  
 PLANNING, INFRASTRUCTURE AND ECONOMIC DEVELOPMENT DEPARTMENT  
 CITY OF OTTAWA

**PLAN 4M-1634**  
 I CERTIFY THAT THIS PLAN IS REGISTERED IN THE LAND REGISTRY OFFICE FOR THE LAND TITLES DIVISION OF OTTAWA-CARLETON No. 4 AT 10:01 O'CLOCK ON THE 2 DAY OF July 2019 AND ENTERED IN THE PARCEL REGISTER FOR PROPERTY IDENTIFIERS 04467-0108 AND 04467-0112 AND THE REQUIRED CONSENTS ARE REGISTERED AS PLAN DOCUMENT NO. 0C2114466  
 Signature: A. McMullen  
 REPRESENTATIVE FOR LAND REGISTRAR

**Committee of Adjustment**  
 Received | Reçu le  
 Revisé | Modifié le : 2023-10-24  
 City of Ottawa | Ville d'Ottawa  
 Comité de dérogation

All of Block 18, PART OF BLOCKS 1, 2, 3, 4, 14 AND 15 AND PART OF RUE LUSK STREET: SUBJECT TO EASEMENT INST. LT754391.

