

UTM: 417237E, 5013796N, Zone 18

Red Line – Area to be Severed
Yellow Line – Lot to be Enlarged
Green Line – Retained Parcel
Blue Circle – Area of Severance

Purple Circle – Location of Buildings on 3247 Old Almonte Road



Committee of Adjustment Received | Reçu le

Revised | Modifié le : 2024-01-30

City of Ottawa | Ville d'Ottawa

Comité de dérogation



KEY MAP

Green Line - Subject Lands 3247 Old Almonte Road

MOORE - HOWIE CONSENT APPLICATION

3247 Old Almonte Road
Lot Line Adjustment
Part Lot 8, 9 and 10 Con 7
Huntley Township
West Carleton Township
City of Ottawa

Lot to Be Enlarged 3266 Peskett Road Part Lot 10 Con 7 Huntley Part 1 5R10828


January 30, 2024 RW Moore

LOCATION OF BUILDINGS AND DISTANCE FROM PROPERTY LINE 3247 OLD ALMONTE ROAD




Severance Boundary 3266 Peskett Road – Yellow Part 1 5R10828

Red Line – Area to be Severed Yellow Line – Lot to be Enlarged Green Line – Retained Parcel Blue Circle – Area of Severance

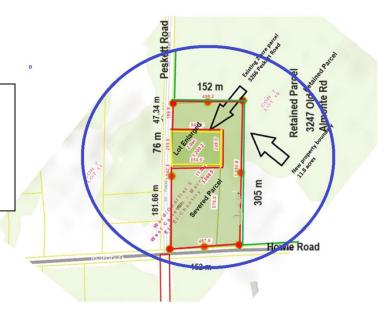

Severed Parcel and Lot to Be Enlarged 3266 Peskett Road –Yellow Part 1 5R10828

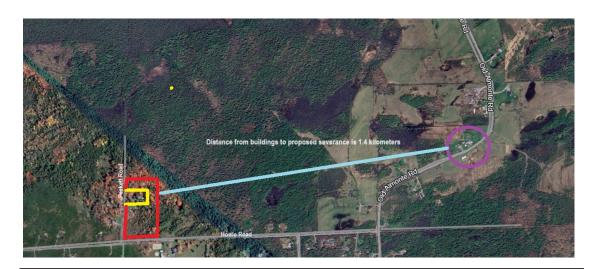

Distance of Existing Buildings (3247 Old Almonte Road) to Proposed Severance Boundary

Photo 1

Entire Parcel


Part Lots 8, 9 and 10 Con 7 Huntley

West Carleton Twp

Committee of Adjustment Received | Reçu le

Revised | Modifié le : 2024-01-15

City of Ottawa | Ville d'Ottawa Comité de dérogation

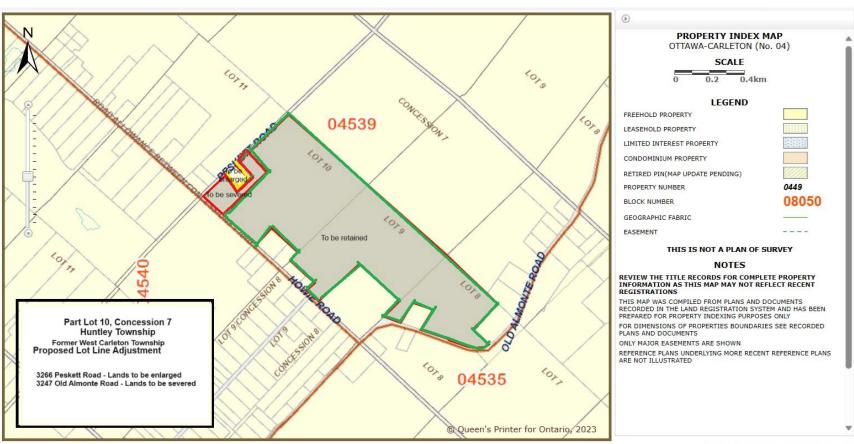

UTM: 417237E, 5013796N, Zone 18

Photo 2

3247 Old Almonte Retained Parcel

Location of Existing Buildings and distance to Severed Parcel

Buildings located at 3247 Old Almonte Road are more than 1.453 km from the boundary of the severed parcel.




Yellow circle is inset of photo of 3247 Old Almonte Road shown in photo 3 below

Photo 3
3247 Old Almonte Retained Parcel



Photo 4

Location of retained, severed and enlarged parcels

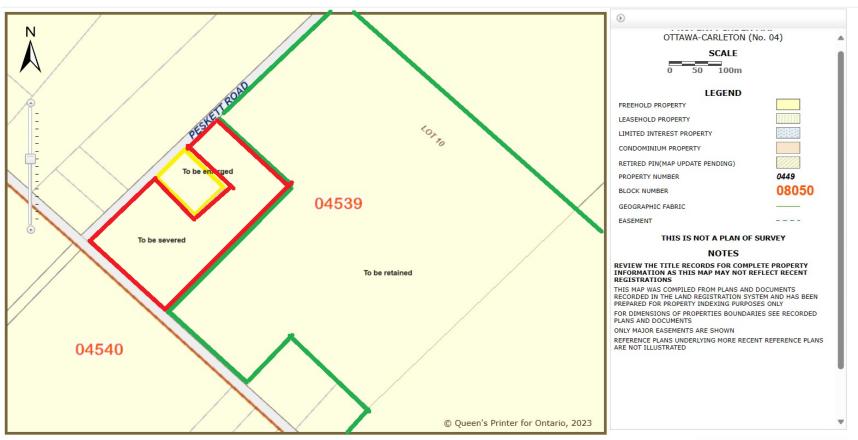

UTM: 418570E, 5003550N, Zone 18

Photo 5

Dimension of severed and enlarged parcels



Photo 6

Air photo of enlarged parcel and severed parcel

One existing building (10 m2) on severed parcel that will be included in enlarged parcel.


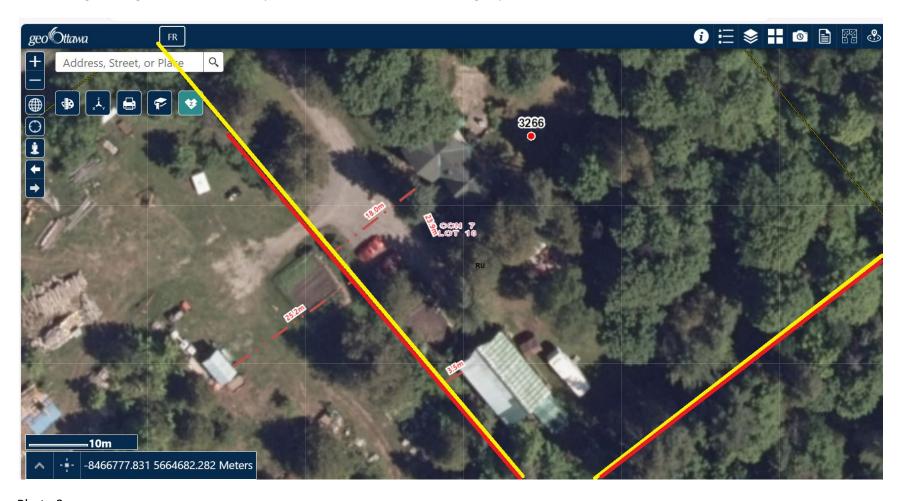


Photo 3

Committee of Adjustment
Received | Reçu le

Revised | Modifié le : 2024-01-15

City of Ottawa | Ville d'Ottawa
Comité de dérogation

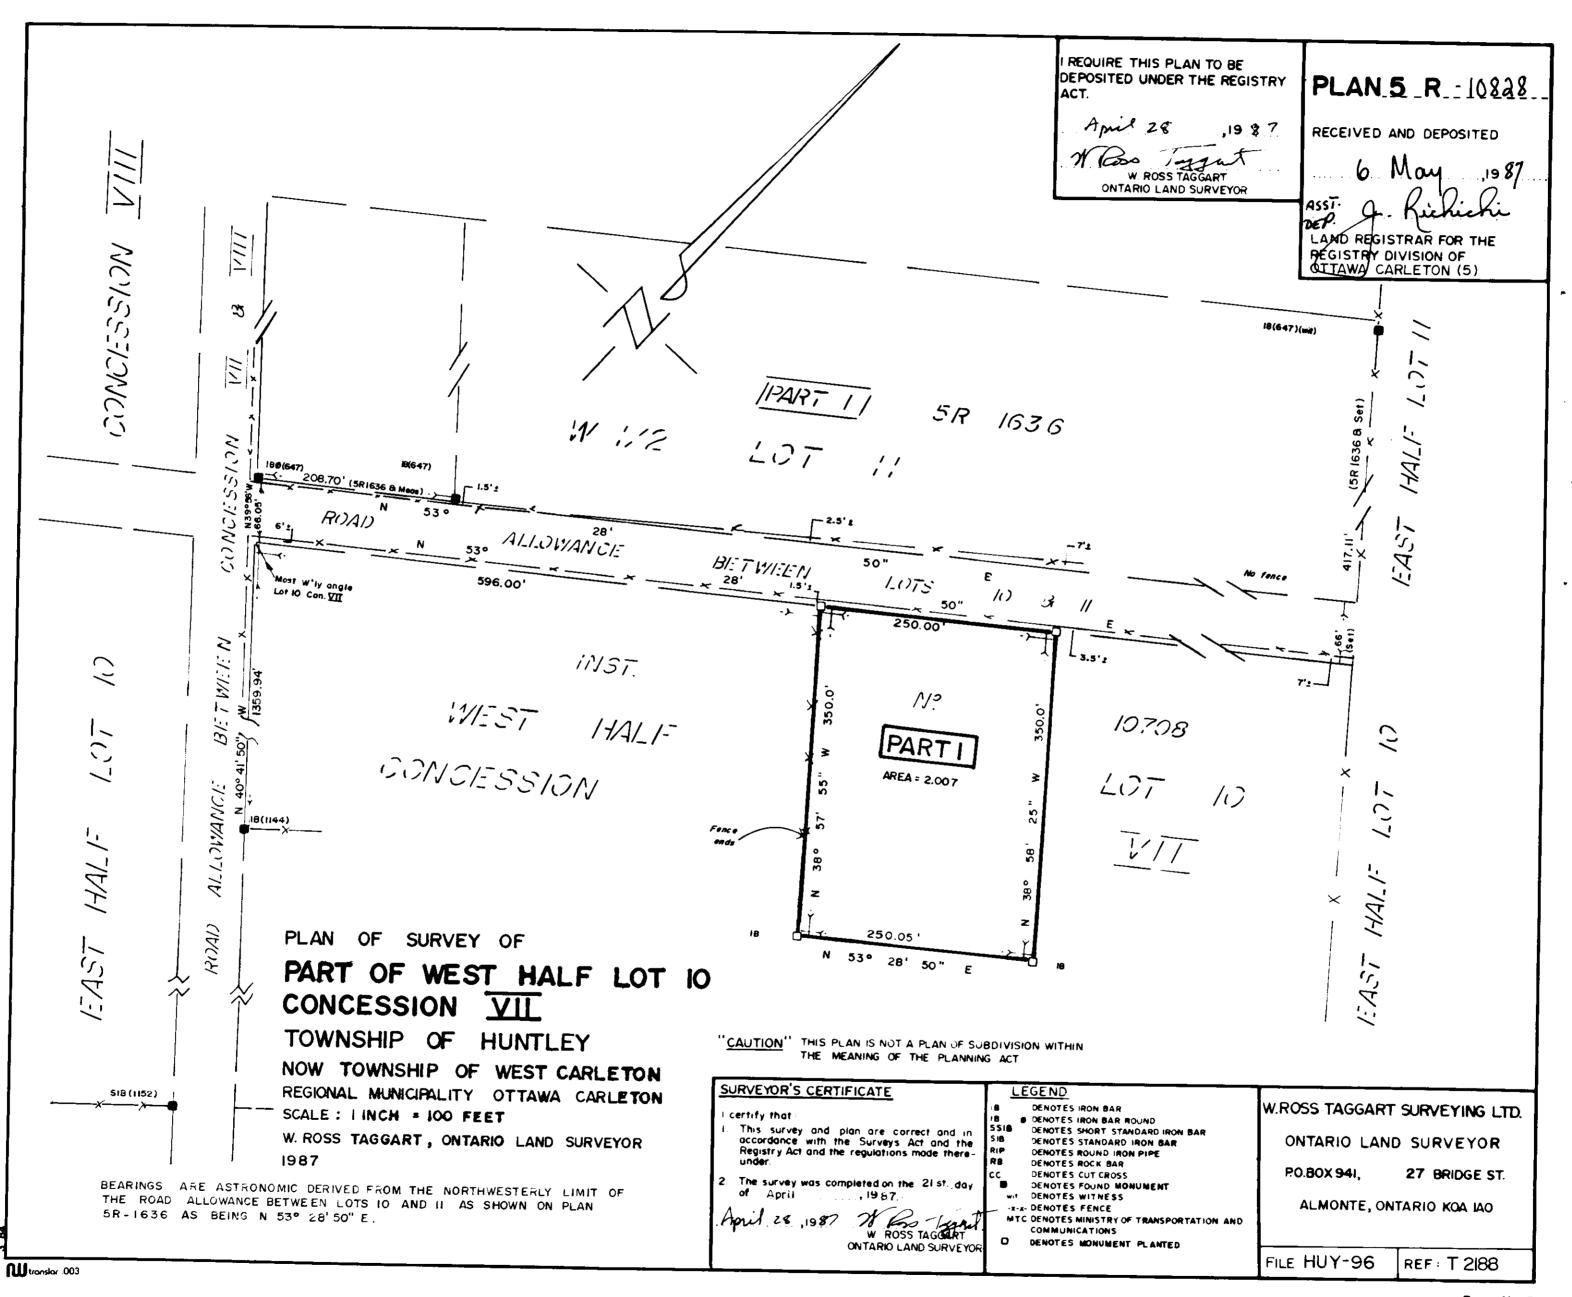


Parcel Geometry


3247 Old Almonte Road

Committee of Adjustment Received | Reçu le

Revised | Modifié le : 2024-01-15


City of Ottawa | Ville d'Ottawa Comité de dérogation

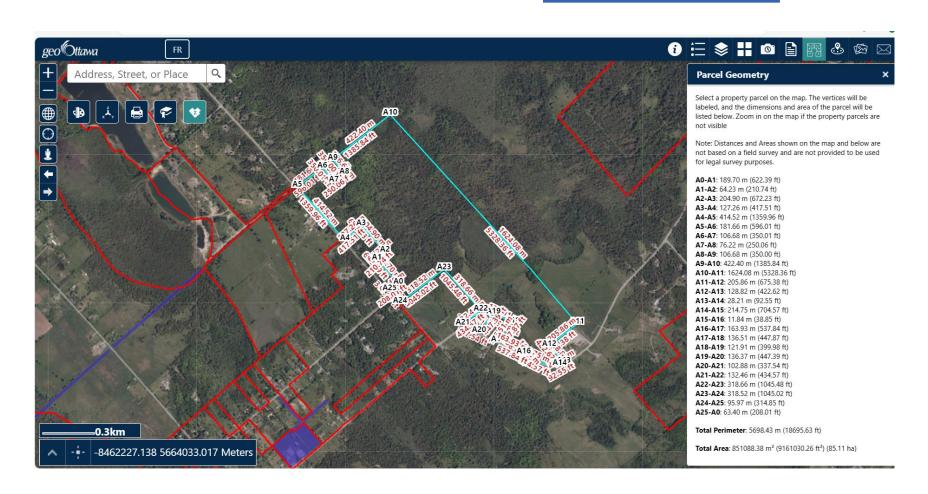

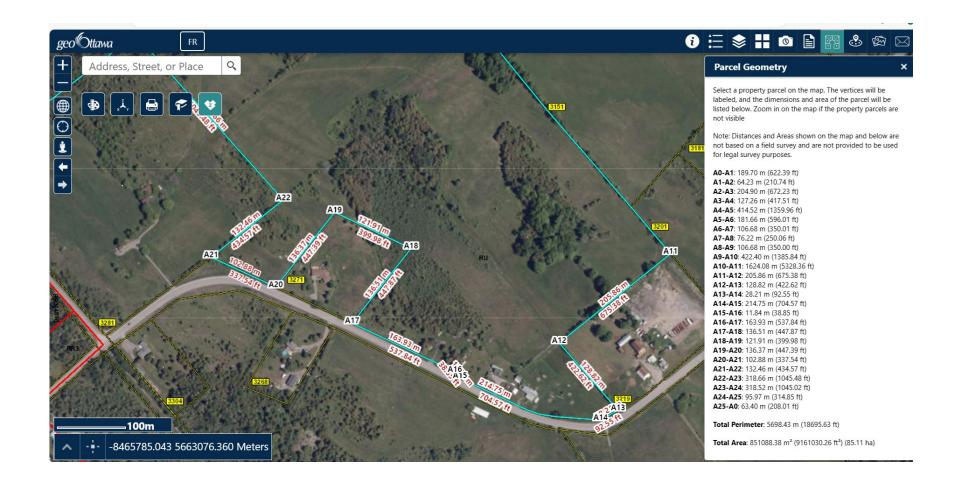

Building Size and Location

3247 Old Almonte Road

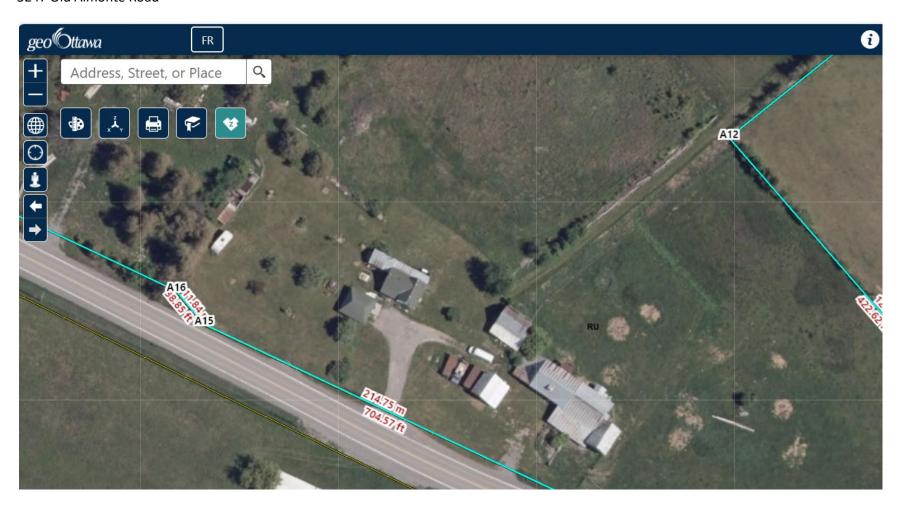

3266 Peskett Road

Parcel Geometry and Buildings

