



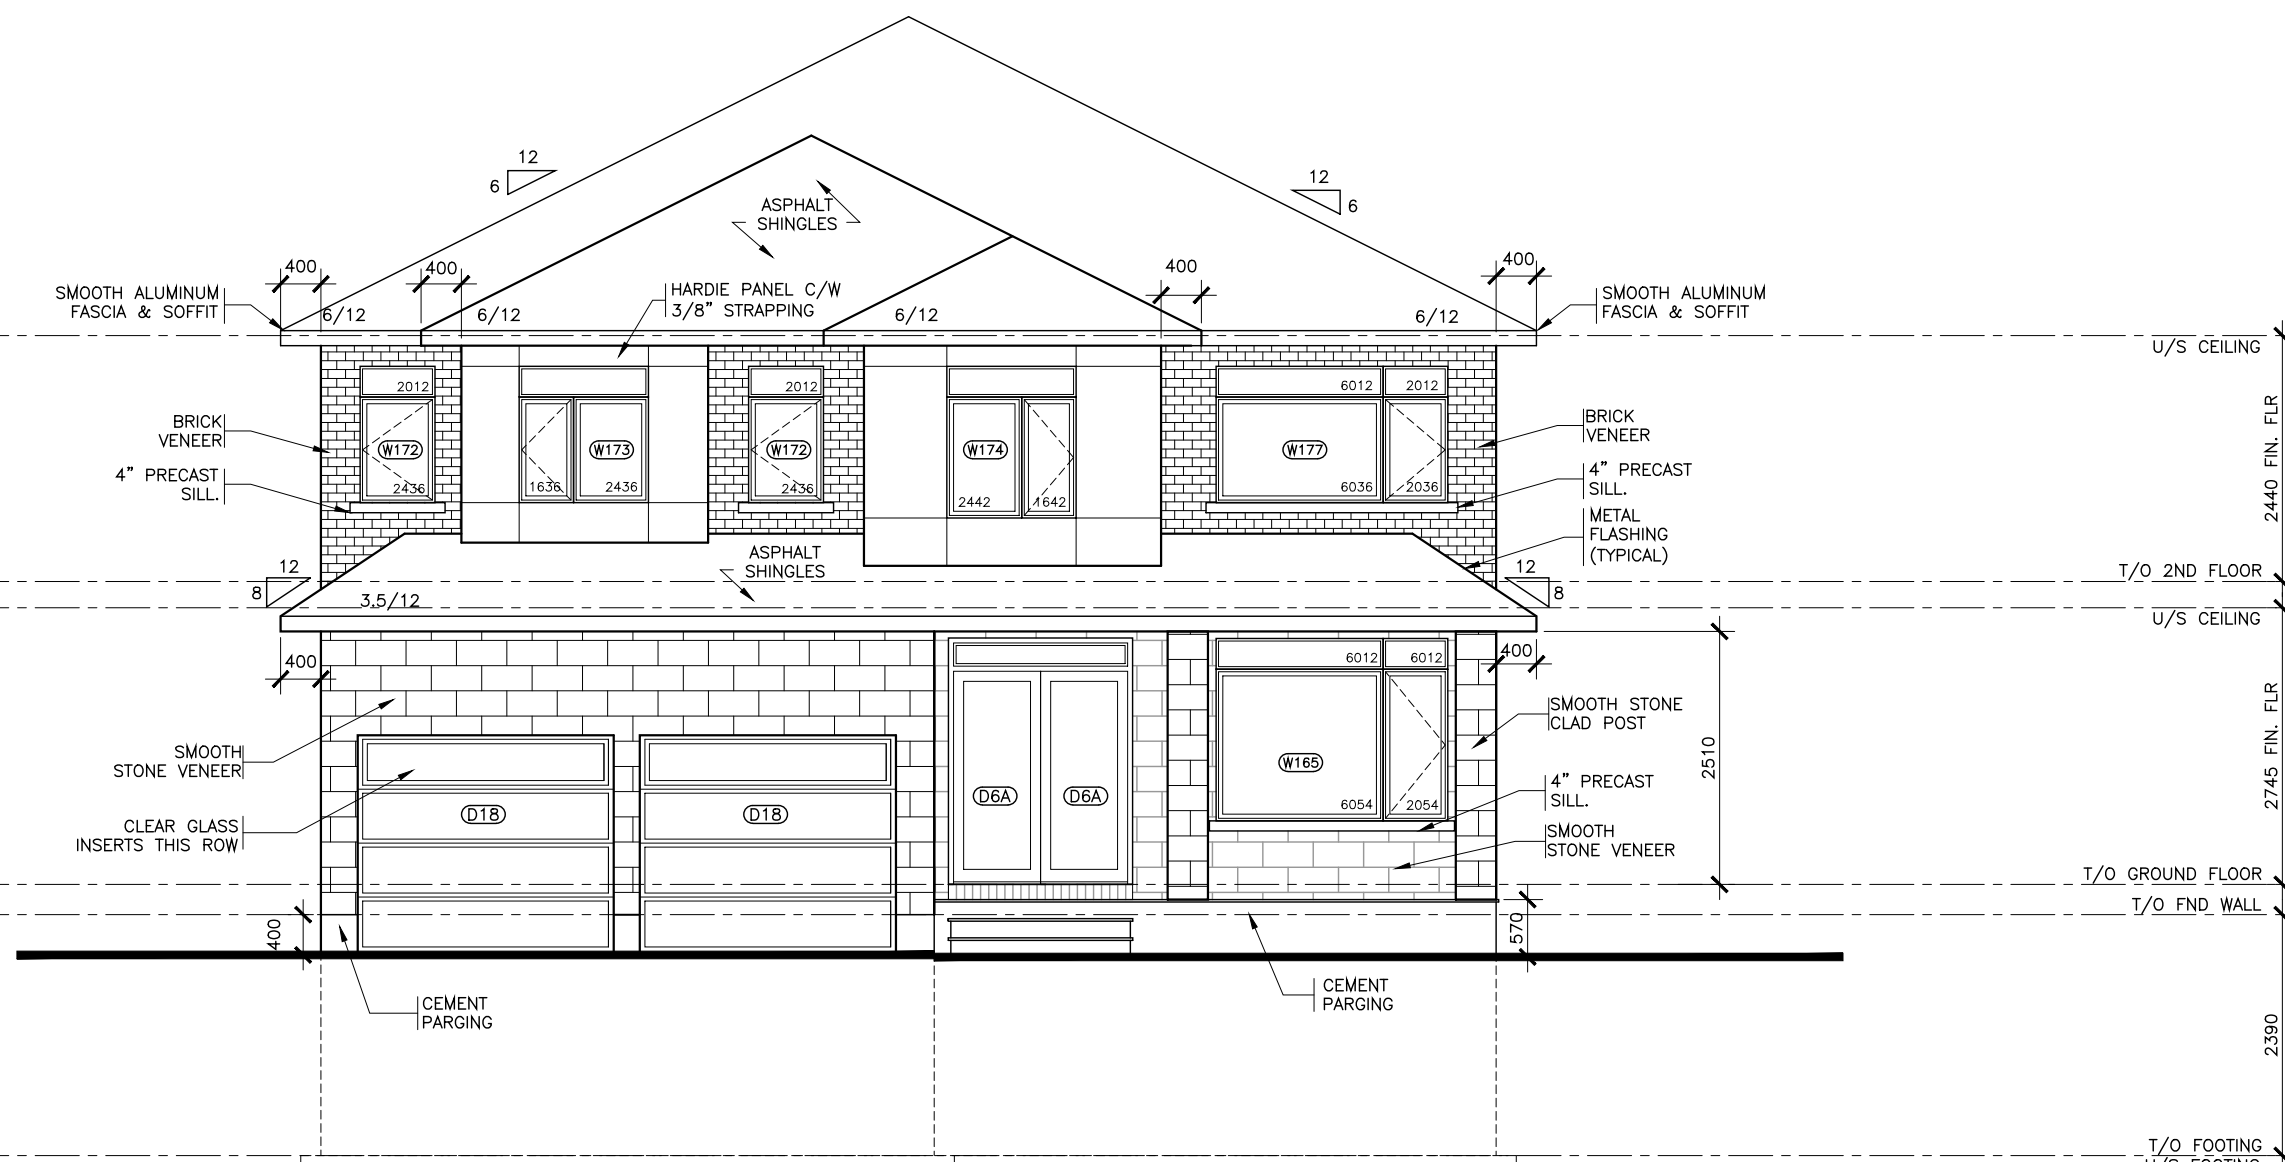

FRONT SIDE
CONTEMPORARY ELEVATION

- NOTE:**
- 1 REFER TO DRAWINGS A9, A10 FOR GENERAL NOTES, TABLES SCHEDULES, CONSTRUCTION ASSEMBLY NOTES APPLICABLE TO ALL DRAWINGS AND LEGENDS APPLICABLE TO ALL DRAWINGS.
 - 2 ALL CLOSET TO HAVE DROPPED HEADERS.
 - 3 ALL VENTILATION FANS TO EXHAUST TO THE EXTERIOR. 6" SMOOTH DUCT, 7" FLEX DUCT.
 - 4 BASEMENT: PROVIDE ONE LINE OF PASSAGE FROM UTILITY ROOM TO EXTERIOR WITH ALL DOORWAYS BEING A MINIMUM OF 32" IN WIDTH.
 - 5 CERAMIC TILE TO BE INSTALLED AS PER 9.30.6 OF O.B.C, REQUIRES 5/8" UNDERLAY
 - 6 FIRE PROTECTION FOR GAS AND ELECTRIC RANGES AS PER 9.10.21 OF O.B.C.
 - 7 BATHROOMS: PROVIDE WATERPROOF WALL FINISH AS PER 9.29.2 OF O.B.C.
 - 8 PROVIDE STUD WALL REINFORCING IN MAIN BATHROOM FOR FUTURE GRAB BARS, AS PER 9.5.2.3. SEE DWG D1
 - 9 ATTIC HATCH SHALL BE LOCATED SO AS TO PROVIDE UNOBSTRUCTED ACCESS TO ATTIC SPACE
 - 10 PROVIDE WARM AIR SUPPLY GRILLE IN W.I.C. WHEN ADJACENT TO UNHEATED SPACE, EXTERIOR AIR, OR EXTERIOR SOIL
 - 11 SMOKE ALARMS LOCATION AND POWER SUPPLY IN DWELLING UNITS WILL COMPLY WITH 9.10.19.3 AND 9.10.19.4. (1).
 - 12 INSTALLATION HEIGHT OF CARBON MONOXIDE DETECTORS WILL COMPLY WITH 9.33.4.2.
 - 13 THE HEIGHT OF HANDRAILS ON STAIRS AND RAMPS SHALL BE NOT LESS THAN 865 AND NOT MORE THAN 965, AS PER 9.8.7.4. (2).

7	SI UPDATED TO #38	JUN.01.22
6	SI UPDATED TO #31	SEP.03.21
5	SI UPDATED TO #30	JUL.20.21
4	SI UPDATED TO #29	FEB.26.21
3	SI UPDATED TO #2	JAN.26.21
2	WALKOUT CONDITION ADDED	OCT.26.20
1	STRUCTURAL REVIEW	NOV.01.18
No.	REVISION	DATE

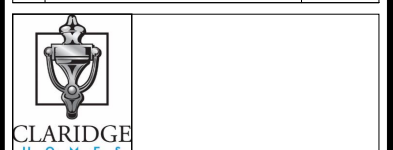

Model Title:
LOCKPORT II 2018
FLOOR AREA: 3446 SQ.FT = 320.1 SQ.M
OTB: 218 SQ.FT = 20.21 SQ.M
BSMT: 719 SQ.FT = 66.75 SQ.M

Project:
**RIVERS EDGE SOUTH
LOT 199**

Title:
**FRONT SIDE
CONTEMPORARY ELEVATION**

AS BUILT RELEASE
No. 1 2019.12.06


BROCHURE DATE
X

Scale: 1 : 75

Drawing No.

Drawn by: DM

A-5.3

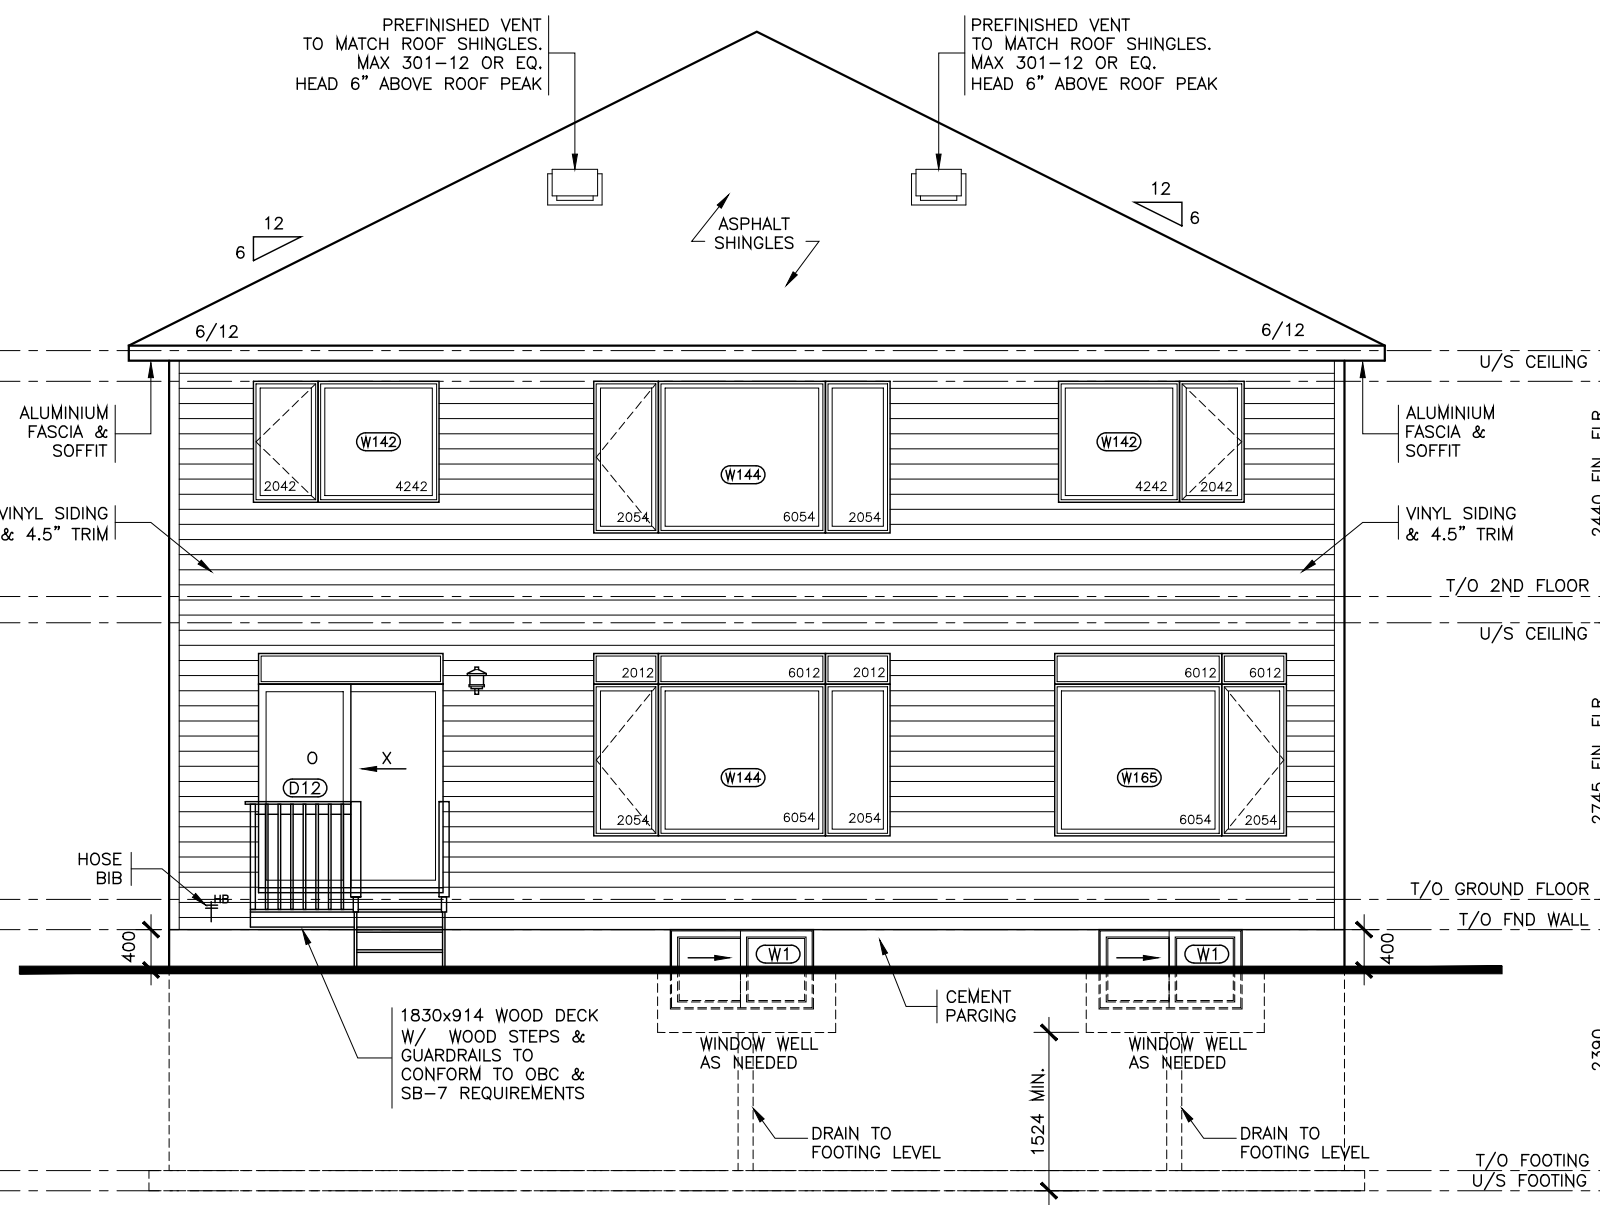

REAR SIDE
CONTEMPORARY ELEVATION

- NOTE:**
- 1 REFER TO DRAWINGS A9, A10 FOR GENERAL NOTES, TABLES SCHEDULES, CONSTRUCTION ASSEMBLY NOTES APPLICABLE TO ALL DRAWINGS AND LEGENDS APPLICABLE TO ALL DRAWINGS.
 - 2 ALL CLOSET TO HAVE DROPPED HEADERS.
 - 3 ALL VENTILATION FANS TO EXHAUST TO THE EXTERIOR. 6" SMOOTH DUCT, 7" FLEX DUCT.
 - 4 BASEMENT: PROVIDE ONE LINE OF PASSAGE FROM UTILITY ROOM TO EXTERIOR WITH ALL DOORWAYS BEING A MINIMUM OF 32" IN WIDTH.
 - 5 CERAMIC TILE TO BE INSTALLED AS PER 9.30.6 OF O.B.C., REQUIRES 5/8" UNDERLAY
 - 6 FIRE PROTECTION FOR GAS AND ELECTRIC RANGES AS PER 9.10.21 OF O.B.C.
 - 7 BATHROOMS: PROVIDE WATERPROOF WALL FINISH AS PER 9.29.2 OF O.B.C.
 - 8 PROVIDE STUD WALL REINFORCING IN MAIN BATHROOM FOR FUTURE GRAB BARS, AS PER 9.5.2.3. SEE DWG D1
 - 9 ATTIC HATCH SHALL BE LOCATED SO AS TO PROVIDE UNOBSTRUCTED ACCES TO ATTIC SPACE
 - 10 PROVIDE WARM AIR SUPPLY GRILLE IN W.I.C. WHEN ADJACENT TO UNHEATED SPACE, EXTERIOR AIR, OR EXTERIOR SOIL
 - 11 SMOKE ALARMS LOCATION AND POWER SUPPLY IN DWELLING UNITS WILL COMPLY WITH 9.10.19.3 AND 9.10.19.4. (1).
 - 12 INSTALLATION HEIGHT OF CARBON MONOXIDE DETECTORS WILL COMPLY WITH 9.33.4.2.
 - 13 THE HEIGHT OF HANDRAILS ON STAIRS AND RAMPS SHALL BE NOT LESS THAN 865 AND NOT MORE THAN 965, AS PER 9.8.7.4. (2).

7	SI UPDATED TO #38	JUN.01.22
6	SI UPDATED TO #31	SEP.03.21
5	SI UPDATED TO #30	JUL.20.21
4	SI UPDATED TO #29	FEB.26.21
3	SI UPDATED TO #2	JAN.26.21
2	WALKOUT CONDITION ADDED	OCT.26.20
1	STRUCTURAL REVIEW	NOV.01.18
No.	REVISION	DATE



Model Title:
LOCKPORT II 2018
FLOOR AREA: 3446 SQ.FT = 320.1 SQ.M
OTB: 218 SQ.FT = 20.21 SQ.M
BSMT: 719 SQ.FT = 66.75 SQ.M

Project:
**RIVERS EDGE SOUTH
LOT 199**

Title:
**REAR SIDE
CONTEMPORARY ELEVATION**

AS BUILT RELEASE
No. 1 2019.12.06


BROCHURE DATE
X

Scale: 1 : 75

Drawing No.

Drawn by: DM

A-6.2

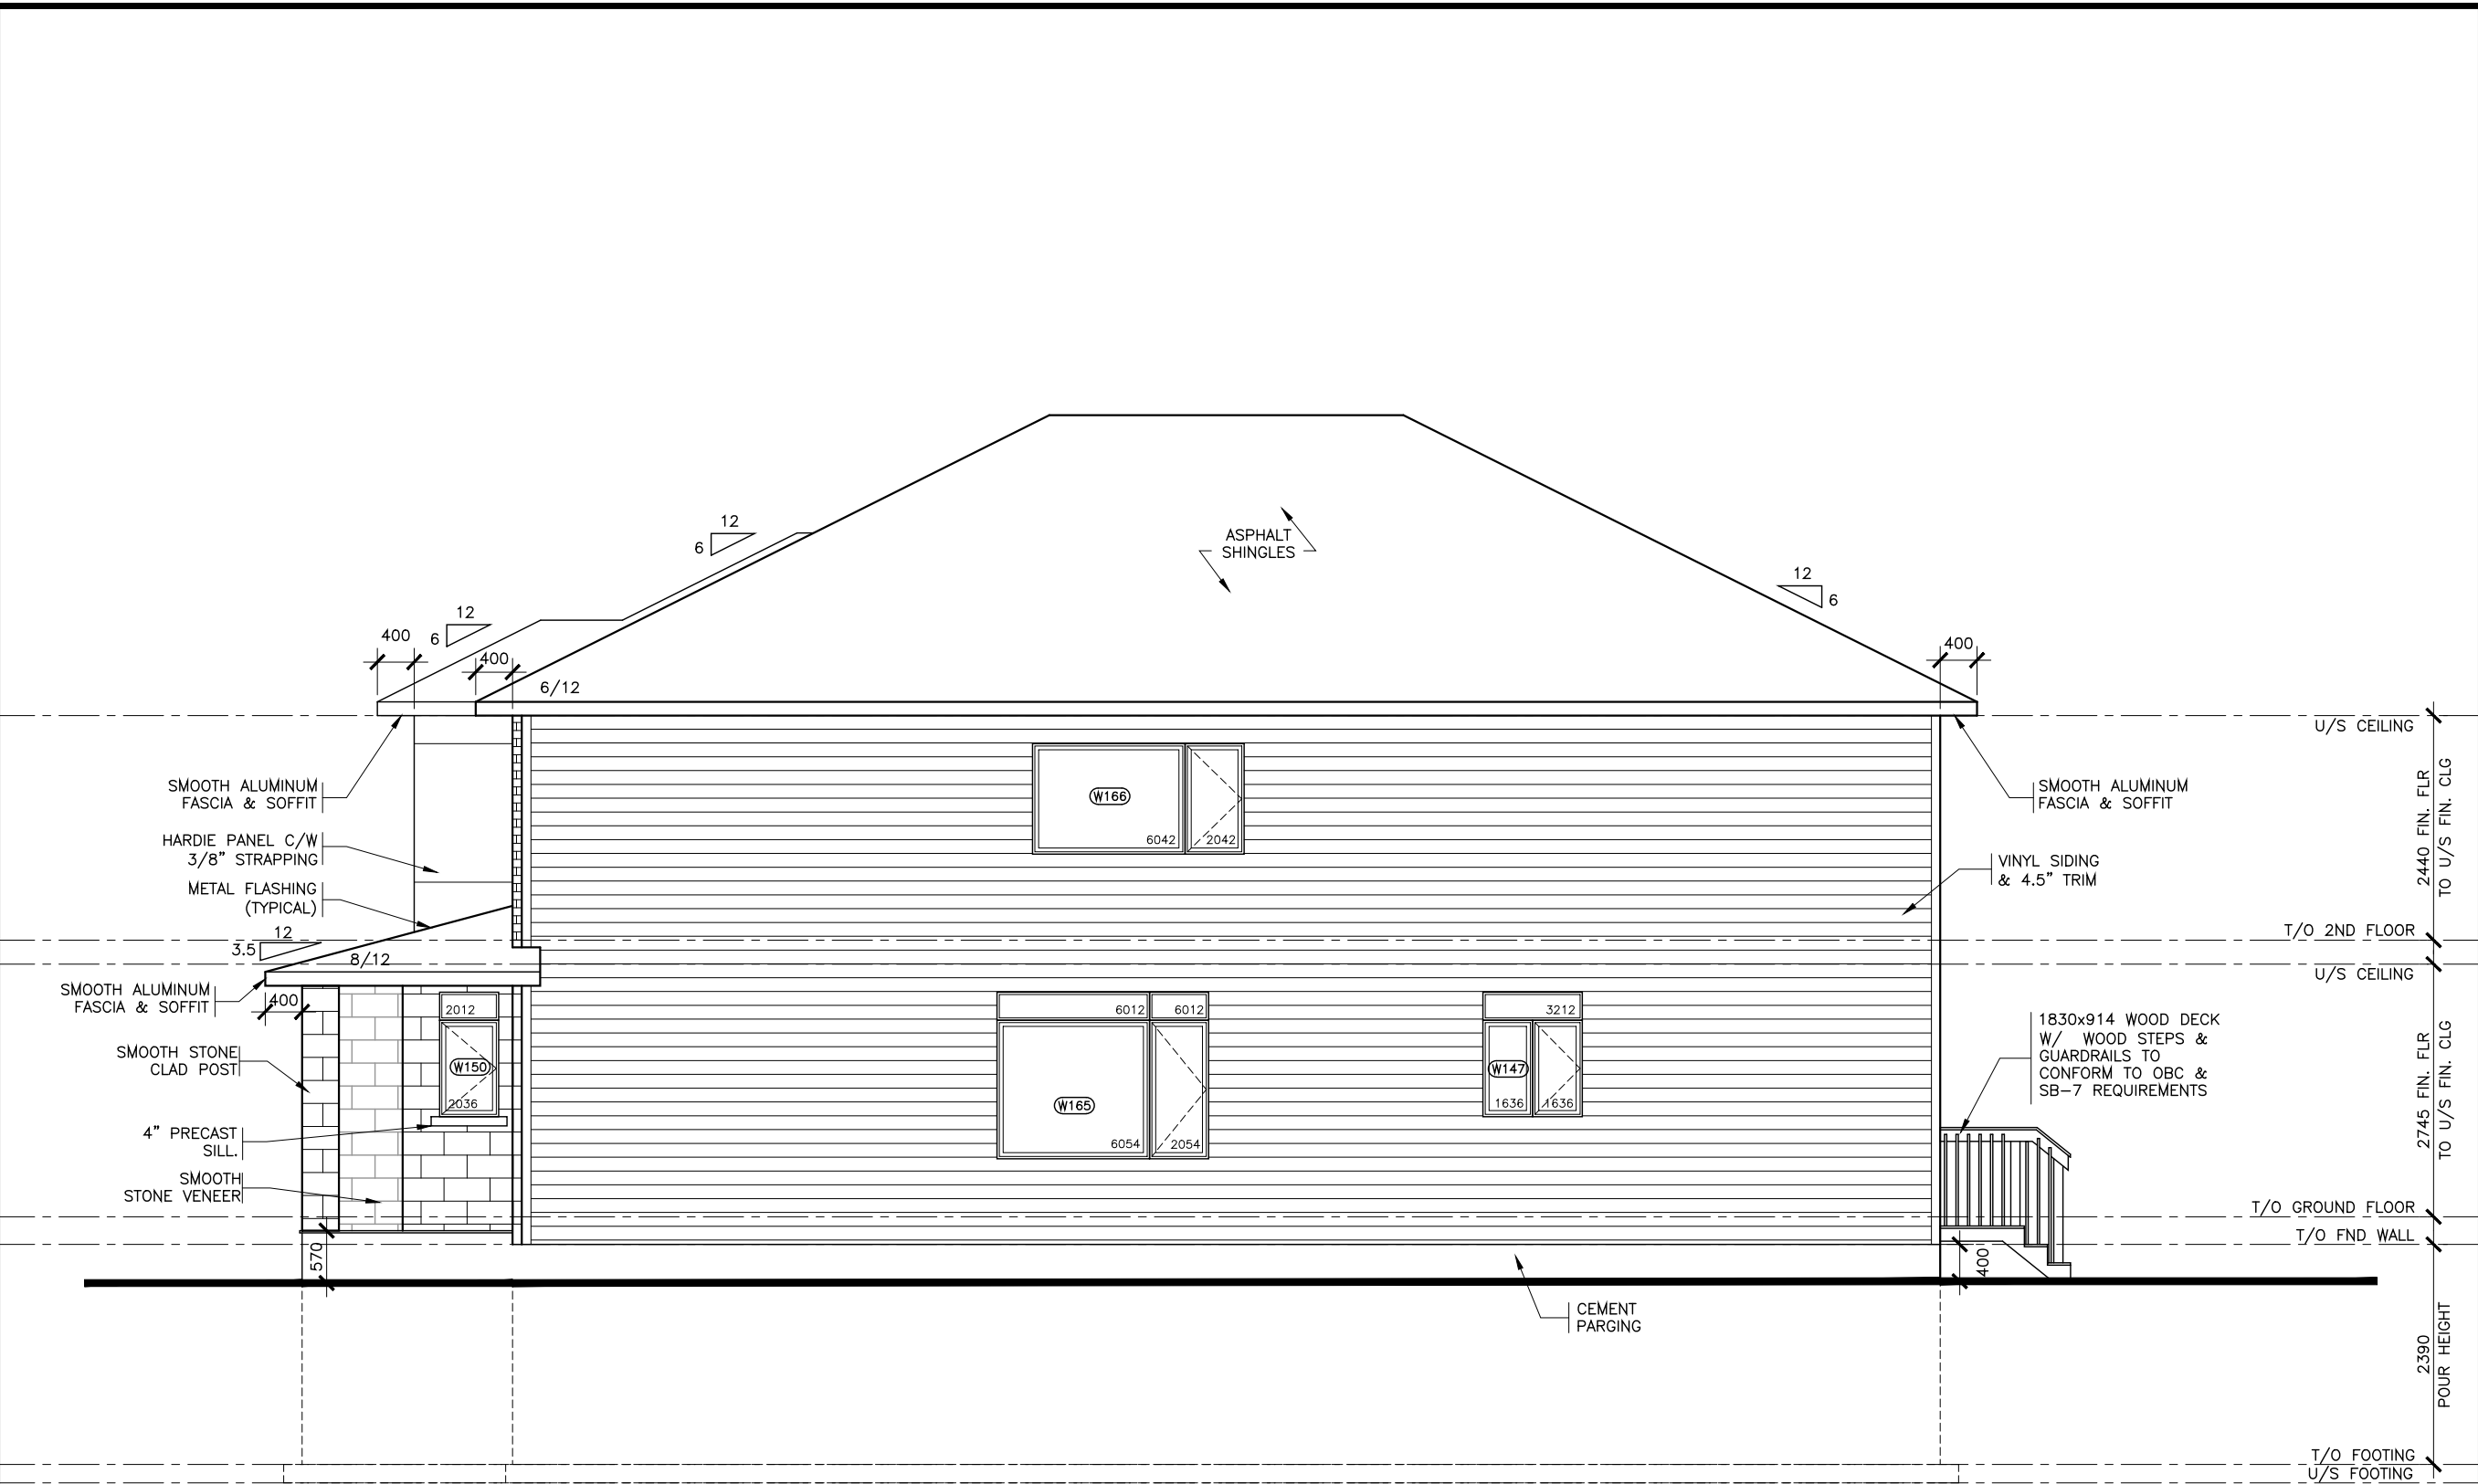

UNPROTECTED OPENINGS
(UPO) CALCULATION:

EXPOSED BUILDING FACE: 99.68m²
UNPROTECTED OPENINGS: 5.78m²
MIN. SETBACK: 1.2m

5.78/99.68 X 100 = 5.80%

RIGHT SIDE
CONTEMPORARY ELEVATION

NOTE:

- 1 REFER TO DRAWINGS A9, A10 FOR GENERAL NOTES, TABLES SCHEDULES, CONSTRUCTION ASSEMBLY NOTES APPLICABLE TO ALL DRAWINGS AND LEGENDS APPLICABLE TO ALL DRAWINGS.
- 2 ALL CLOSET TO HAVE DROPPED HEADERS.
- 3 ALL VENTILATION FANS TO EXHAUST TO THE EXTERIOR. 6" SMOOTH DUCT, 7" FLEX DUCT.
- 4 BASEMENT: PROVIDE ONE LINE OF PASSAGE FROM UTILITY ROOM TO EXTERIOR WITH ALL DOORWAYS BEING A MINIMUM OF 32" IN WIDTH.
- 5 CERAMIC TILE TO BE INSTALLED AS PER 9.30.6 OF O.B.C., REQUIRES 5/8" UNDERLAY
- 6 FIRE PROTECTION FOR GAS AND ELECTRIC RANGES AS PER 9.10.21 OF O.B.C.
- 7 BATHROOMS: PROVIDE WATERPROOF WALL FINISH AS PER 9.29.2 OF O.B.C.
- 8 PROVIDE STUD WALL REINFORCING IN MAIN BATHROOM FOR FUTURE GRAB BARS, AS PER 9.5.2.3. SEE DWG D1
- 9 ATTIC HATCH SHALL BE LOCATED SO AS TO PROVIDE UNOBSTRUCTED ACCES TO ATTIC SPACE
- 10 PROVIDE WARM AIR SUPPLY GRILLE IN W.I.C. WHEN ADJACENT TO UNHEATED SPACE, EXTERIOR AIR, OR EXTERIOR SOIL
- 11 SMOKE ALARMS LOCATION AND POWER SUPPLY IN DWELLING UNITS WILL COMPLY WITH 9.10.19.3 AND 9.10.19.4. (1).
- 12 INSTALLATION HEIGHT OF CARBON MONOXIDE DETECTORS WILL COMPLY WITH 9.33.4.2.
- 13 THE HEIGHT OF HANDRAILS ON STAIRS AND RAMPS SHALL BE NOT LESS THAN 865 AND NOT MORE THAN 965, AS PER 9.8.7.4. (2).

7	SI UPDATED TO #38	JUN.01.22
6	SI UPDATED TO #31	SEP.03.21
5	SI UPDATED TO #30	JUL.20.21
4	SI UPDATED TO #29	FEB.26.21
3	SI UPDATED TO #2	JAN.26.21
2	WALKOUT CONDITION ADDED	OCT.26.20
1	STRUCTURAL REVIEW	NOV.01.18
No.	REVISION	DATE



Model Title:
LOCKPORT II 2018
FLOOR AREA: 3446 SQ.FT = 320.1 SQ.M
OTB: 218 SQ.FT = 20.21 SQ.M
BSMT: 719 SQ.FT = 66.75 SQ.M

Project:
**RIVERS EDGE SOUTH
LOT 199**

Title:
**RIGHT SIDE
CONTEMPORARY ELEVATION**

AS BUILT RELEASE
No. 1 2019.12.06


BROCHURE DATE
X

Scale: 1 : 75

Drawing No.

Drawn by: DM


A-7.3

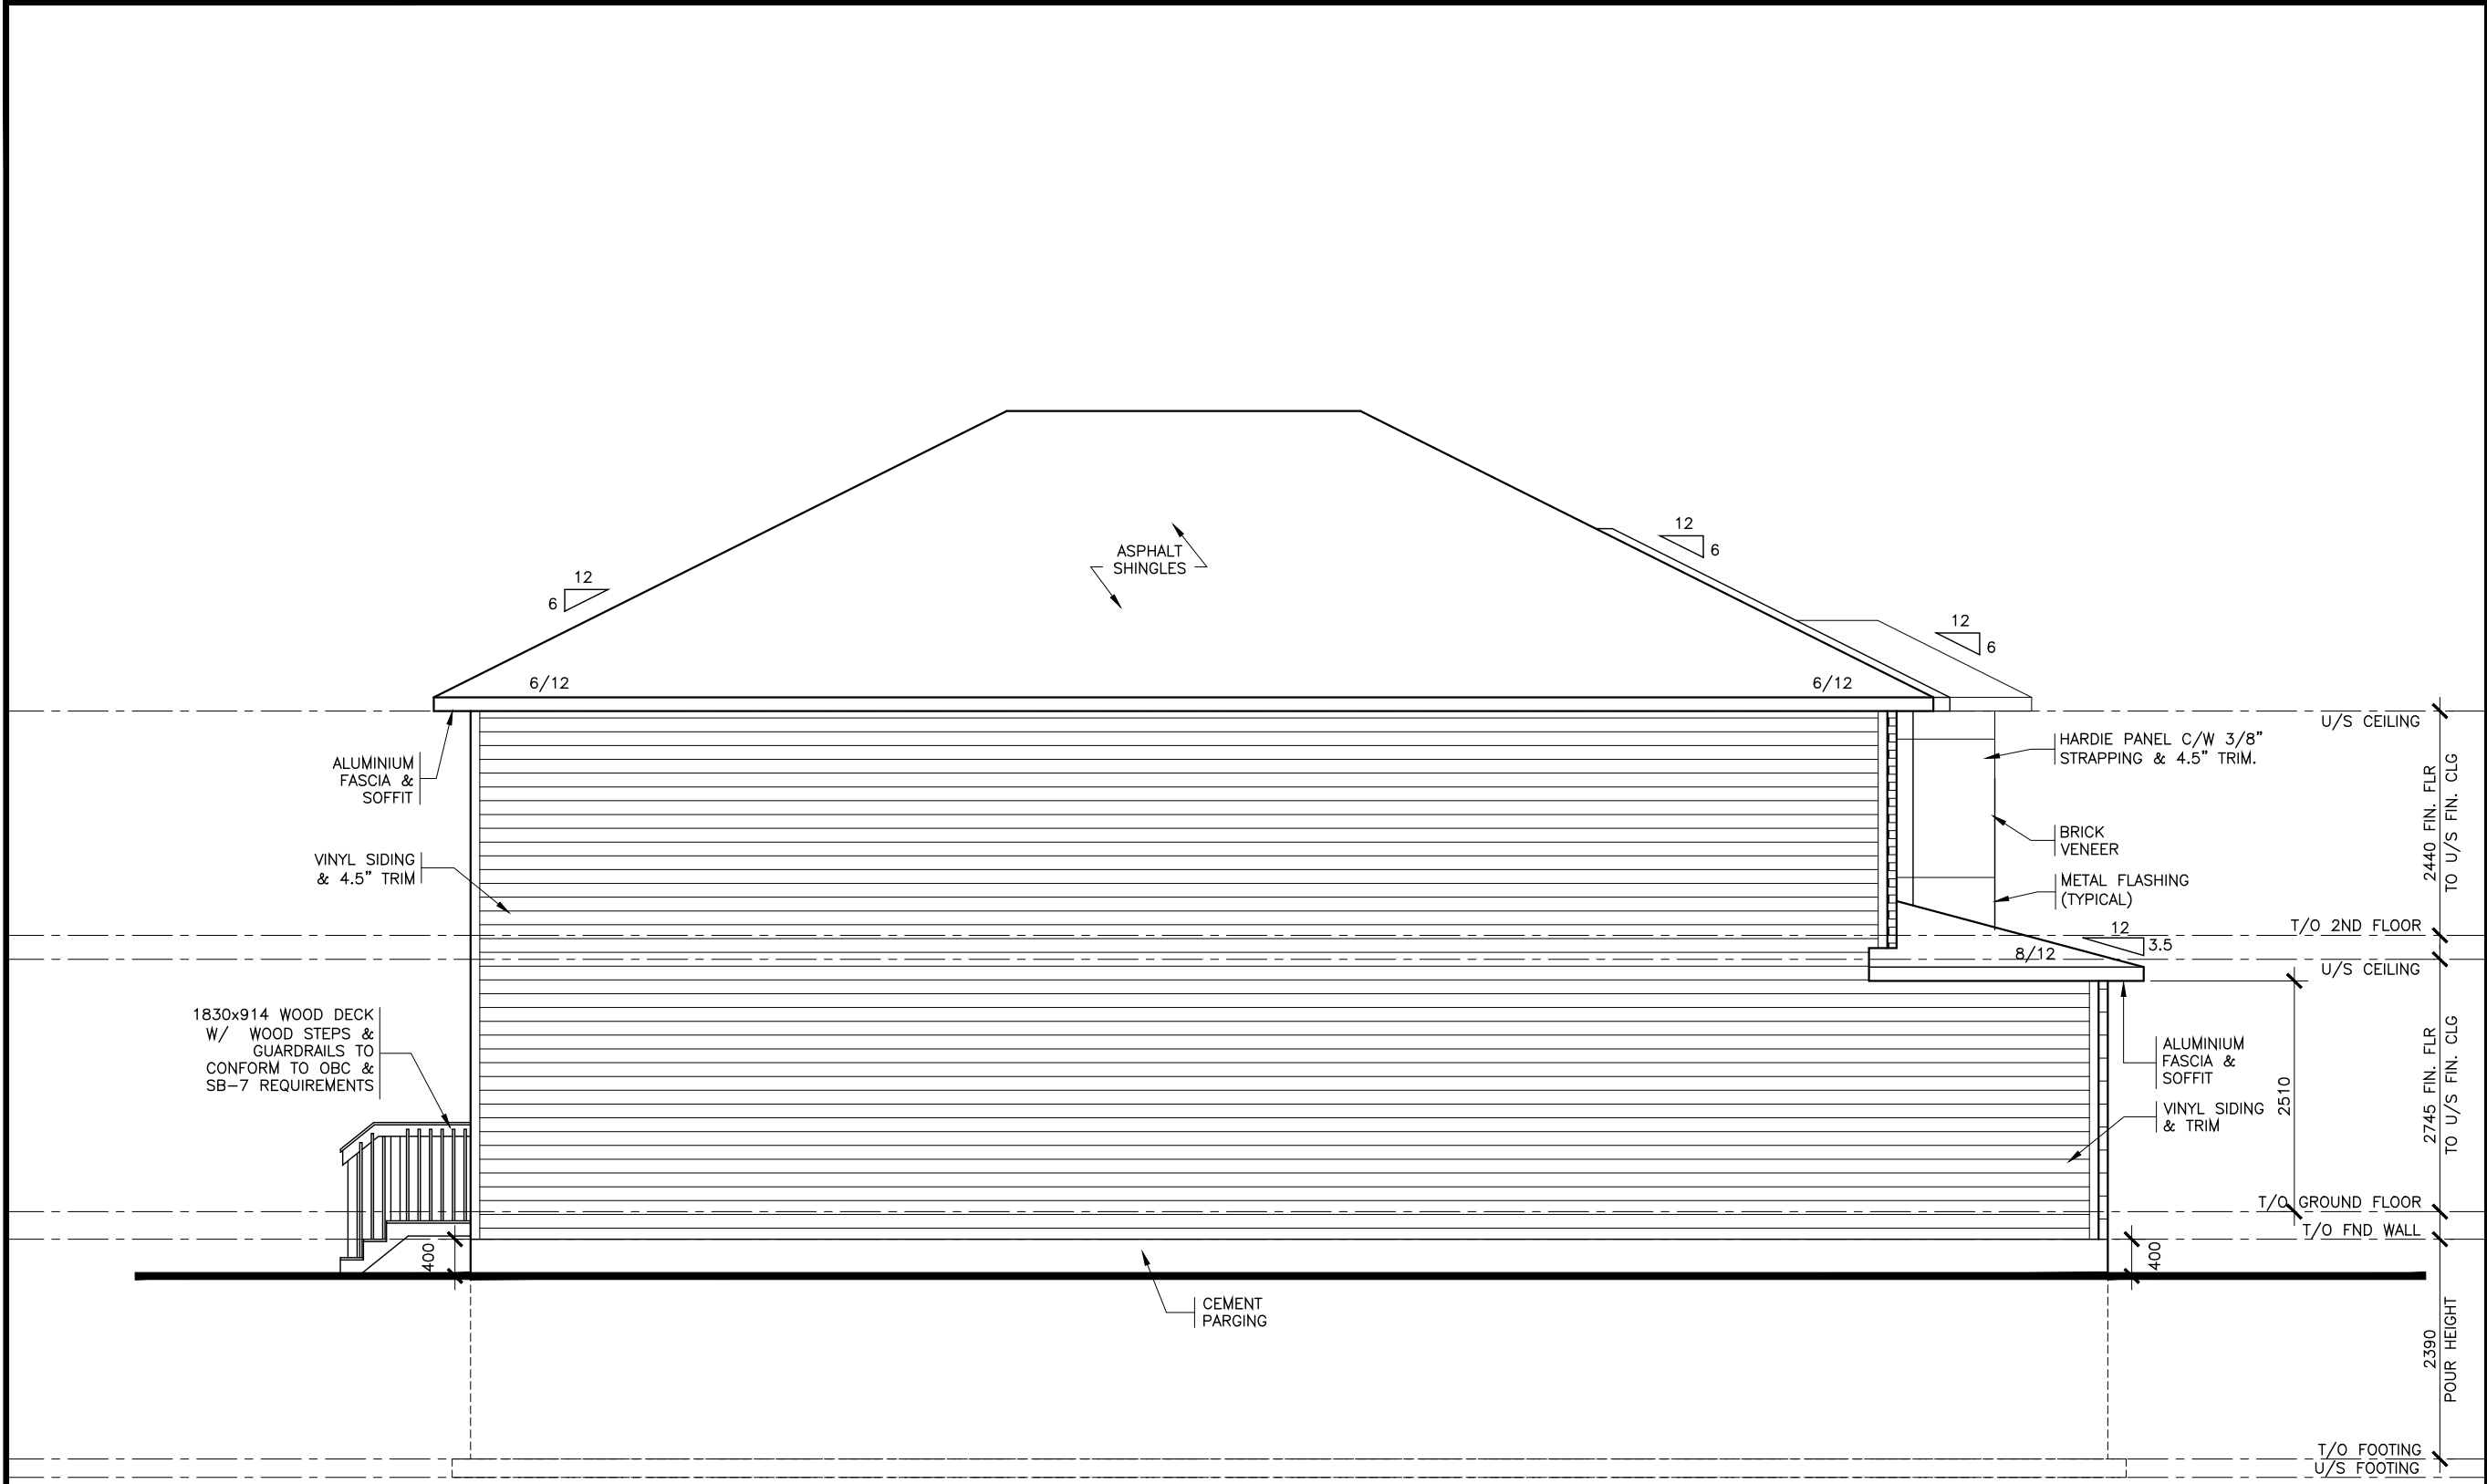

LEFT SIDE
CONTEMPORARY ELEVATION

- NOTE:**
- 1 REFER TO DRAWINGS A9, A10 FOR GENERAL NOTES, TABLES SCHEDULES, CONSTRUCTION ASSEMBLY NOTES APPLICABLE TO ALL DRAWINGS AND LEGENDS APPLICABLE TO ALL DRAWINGS.
 - 2 ALL CLOSET TO HAVE DROPPED HEADERS.
 - 3 ALL VENTILATION FANS TO EXHAUST TO THE EXTERIOR. 6" SMOOTH DUCT, 7" FLEX DUCT.
 - 4 BASEMENT: PROVIDE ONE LINE OF PASSAGE FROM UTILITY ROOM TO EXTERIOR WITH ALL DOORWAYS BEING A MINIMUM OF 32" IN WIDTH.
 - 5 CERAMIC TILE TO BE INSTALLED AS PER 9.30.6 OF O.B.C., REQUIRES 5/8" UNDERLAY
 - 6 FIRE PROTECTION FOR GAS AND ELECTRIC RANGES AS PER 9.10.21 OF O.B.C.
 - 7 BATHROOMS: PROVIDE WATERPROOF WALL FINISH AS PER 9.29.2 OF O.B.C.
 - 8 PROVIDE STUD WALL REINFORCING IN MAIN BATHROOM FOR FUTURE GRAB BARS, AS PER 9.5.2.3. SEE DWG D1
 - 9 ATTIC HATCH SHALL BE LOCATED SO AS TO PROVIDE UNOBSTRUCTED ACCES TO ATTIC SPACE
 - 10 PROVIDE WARM AIR SUPPLY GRILLE IN W.I.C. WHEN ADJACENT TO UNHEATED SPACE, EXTERIOR AIR, OR EXTERIOR SOIL
 - 11 SMOKE ALARMS LOCATION AND POWER SUPPLY IN DWELLING UNITS WILL COMPLY WITH 9.10.19.3 AND 9.10.19.4. (1).
 - 12 INSTALLATION HEIGHT OF CARBON MONOXIDE DETECTORS WILL COMPLY WITH 9.33.4.2.
 - 13 THE HEIGHT OF HANDRAILS ON STAIRS AND RAMPS SHALL BE NOT LESS THAN 865 AND NOT MORE THAN 965, AS PER 9.8.7.4. (2).

7	SI UPDATED TO #38	JUN.01.22
6	SI UPDATED TO #31	SEP.03.21
5	SI UPDATED TO #30	JUL.20.21
4	SI UPDATED TO #29	FEB.26.21
3	SI UPDATED TO #2	JAN.26.21
2	WALKOUT CONDITION ADDED	OCT.26.20
1	STRUCTURAL REVIEW	NOV.01.18
No.	REVISION	DATE

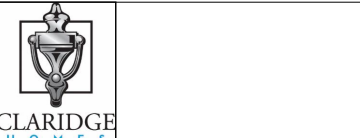

Model Title:
LOCKPORT II 2018
FLOOR AREA: 3446 SQ.FT = 320.1 SQ.M
OTB: 218 SQ.FT = 20.21 SQ.M
BSMT: 719 SQ.FT = 66.75 SQ.M

Project:
**RIVERS EDGE SOUTH
LOT 199**

Title:
**LEFT SIDE
CONTEMPORARY ELEVATION**

AS BUILT RELEASE
No. 1 2019.12.06

BROCHURE DATE
X

Scale: 1 : 75

Drawing No.

Drawn by: DM

A-8.3