


METRIC
DISTANCES AND COORDINATES SHOWN ON THIS PLAN ARE IN METRES
AND CAN BE CONVERTED TO FEET BY DIVIDING BY 0.3048

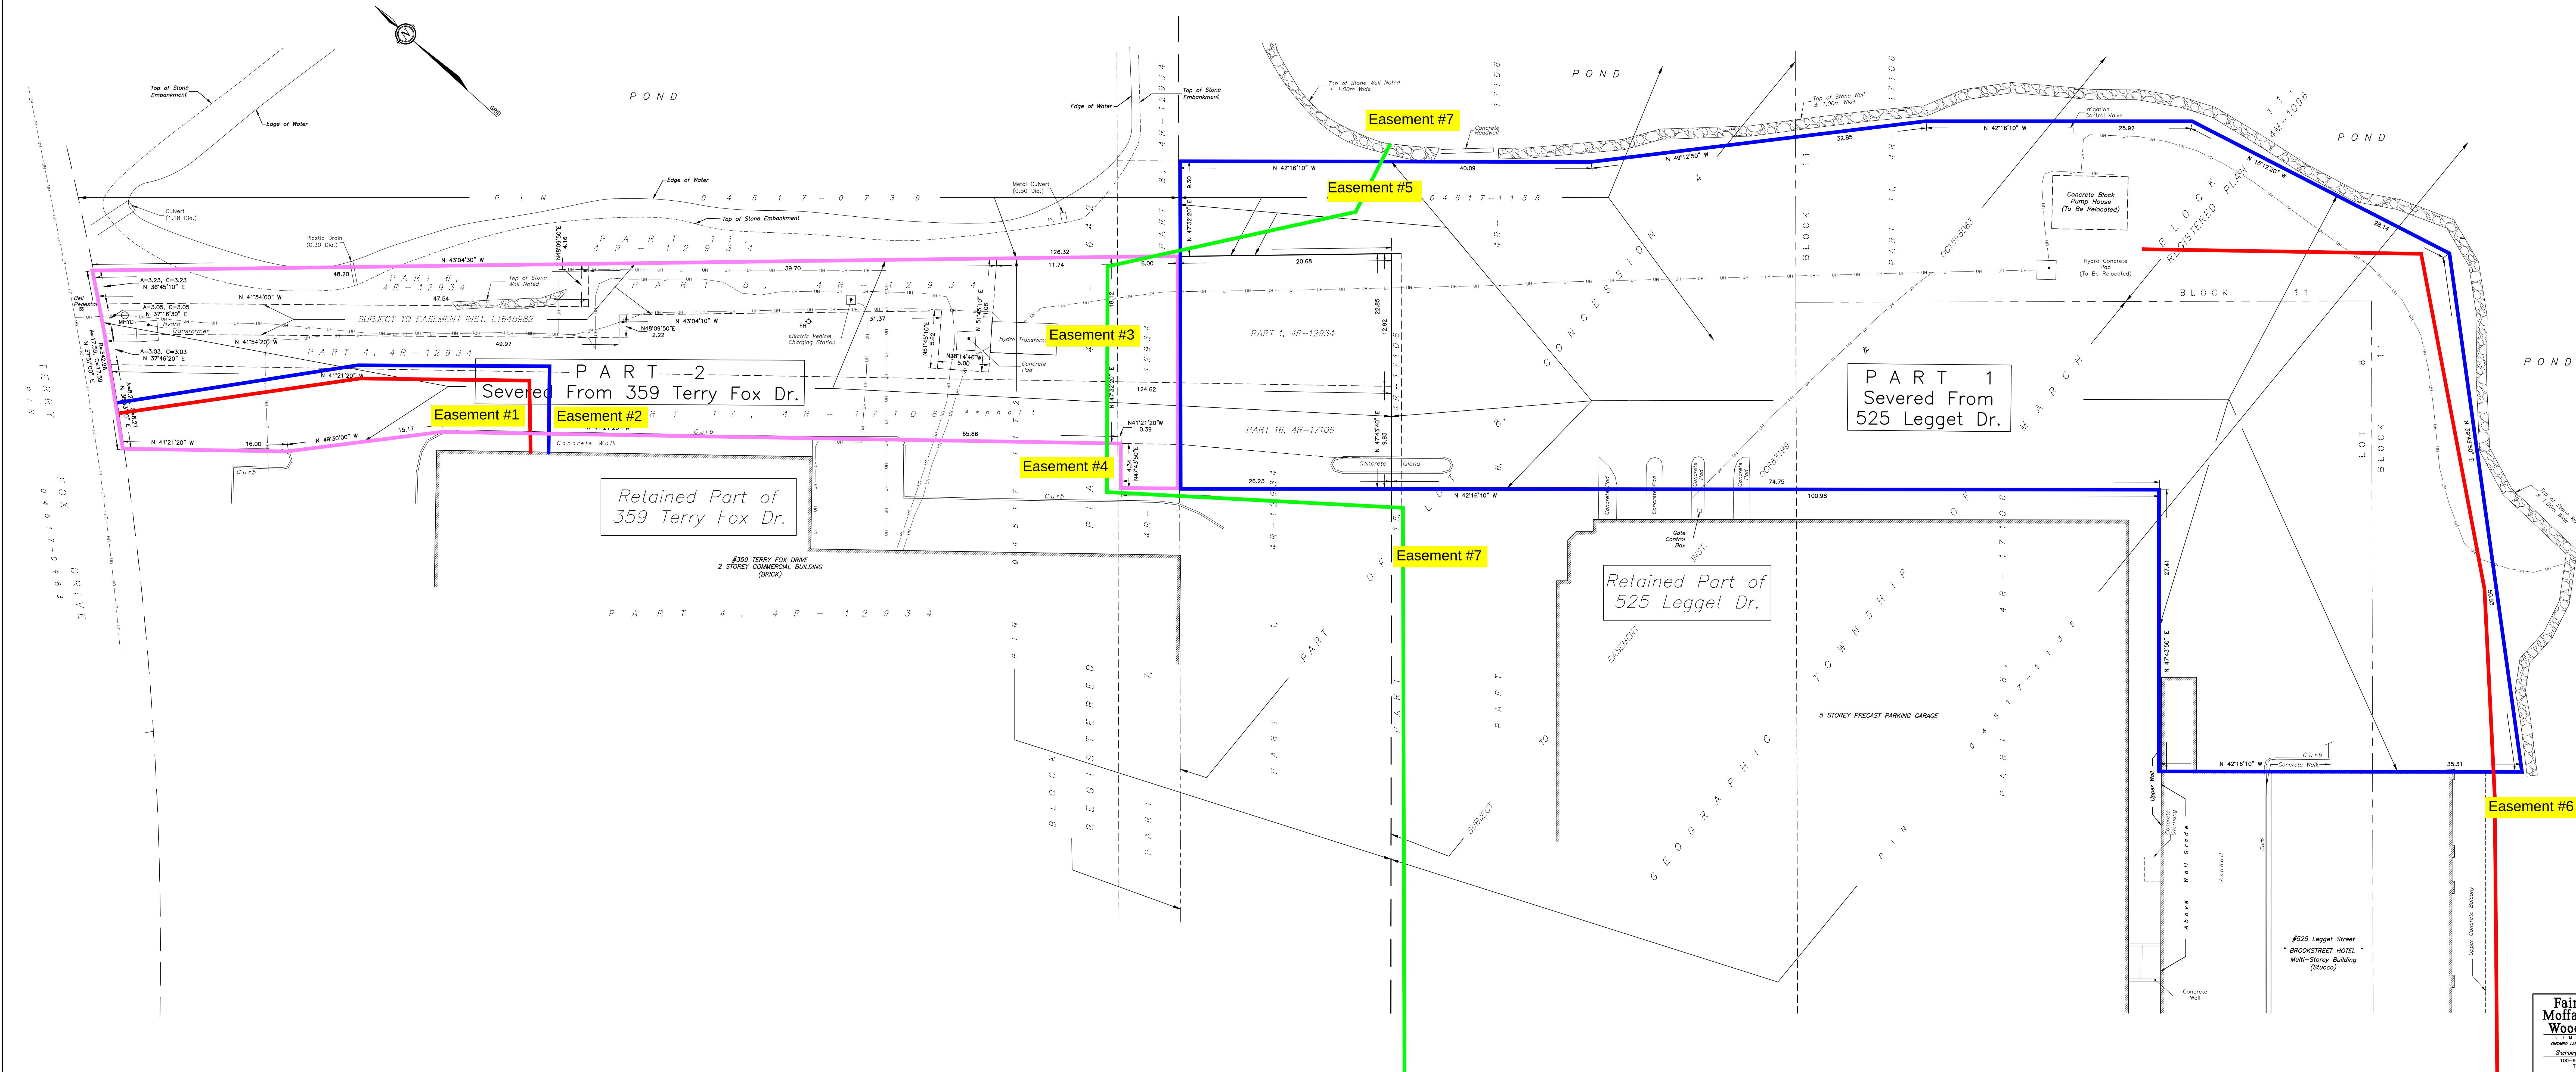

SKETCH SHOWING PROPOSED LIMITS OF
PART OF BLOCK 2
REGISTERED PLAN 4M-642
PART OF BLOCK 11
REGISTERED PLAN 4M-1096
AND
PART OF LOT 8
CONCESSION 4
GEOGRAPHIC TOWNSHIP OF MARCH
NOW CITY OF OTTAWA
SCALE 1 : 200
FAIRHALL, MOFFATT & WOODLAND LIMITED
ONTARIO LAND SURVEYORS

NOTES
1. BEARINGS HEREON ARE GRID BEARINGS AND ARE DERIVED FROM NCC
HORIZONTAL CONTROL MONUMENTS 019791036 (N 5024574.054,
E 348805.939) AND 019791037 (N 5025883.799, E 347613.861)
AND ARE REFERRED TO THE CENTRAL MERIDIAN 76°30'W LONGITUDE,
ZONE 9 OF THE 3° M.T.M. ONTARIO COORDINATE SYSTEM (NAD 83).
2. DISTANCES ARE GROUND AND CAN BE CONVERTED TO GRID BY
MULTIPLYING BY THE COMBINED SCALE FACTOR 0.999919.

LEGEND
PIN - PROPERTY IDENTIFIER NUMBER
RCS - RECORD OF SITE CONDITIONS
UH - UNDERGROUND HYDRO
MHYD - MANHOLE - HYDRO
CURB - CURB
FH - FIRE HYDRANT

Novatech Markup of FMW Sketch

Brookstreet Apartments
June 6, 2022

**Fairhall
Moffatt &
Woodland**
LIMITED
Surveying and Land Information Services
100-600 TERRY FOX DRIVE, KANATA, ONTARIO K2L 4K6
TEL: (613) 591-2280 FAX: (613) 591-1495
www.fmw.on.ca

OTAWA
211-4-MARCH
22 - 4M - 1096
S:\085\VA5700\JWG 2022-06-03
sk_ao257-limits.dwg (cnc)

JOB No.
A A 2 5 7 0 0
E 350506, N 5023420
REFERENCE No.
211-4-MARCH
22 - 4M - 1096
S:\085\VA5700\JWG 2022-06-03
sk_ao257-limits.dwg (cnc)

THIS IS NOT
A VALID COPY
UNLESS EMBOSSED
WITH SEAL